

A1									
	A	18/10/2023	Builders Issue						
	REV NO	DATE	REVISION PURPOSE / DESCRIPTION	DRAWN	RPEQ	RPEQ No	INITIALS	DATE	

DRAWN	CM	06.10.2023
CHECKED	JL	11.10.2023
APPROVED		

SH saunders havill group
 Saunders Havill Group Pty Ltd ABN 24 144 572 540
 head office 9 Thompson St Bowen Hills Q 4006
 phone 090 433 5142 web www.saundershavill.com
 ■ surveying ■ town planning ■ urban design ■ environmental management ■ landscape architecture


Drawing No: 11200 S 04 AC A



ADORA ESTATE
 BEAUDESERT ROAD, PARKINSON
 PLAN OF ADAC SURVEY DATA
 SEWERAGE RETICULATION 22-PNT-61795


DRAWING STATUS AS CONSTRUCTED	
SHEET 1 OF 5 SHEETS	
DRAWING NO.	REV.
	A

SEE SHEET 1

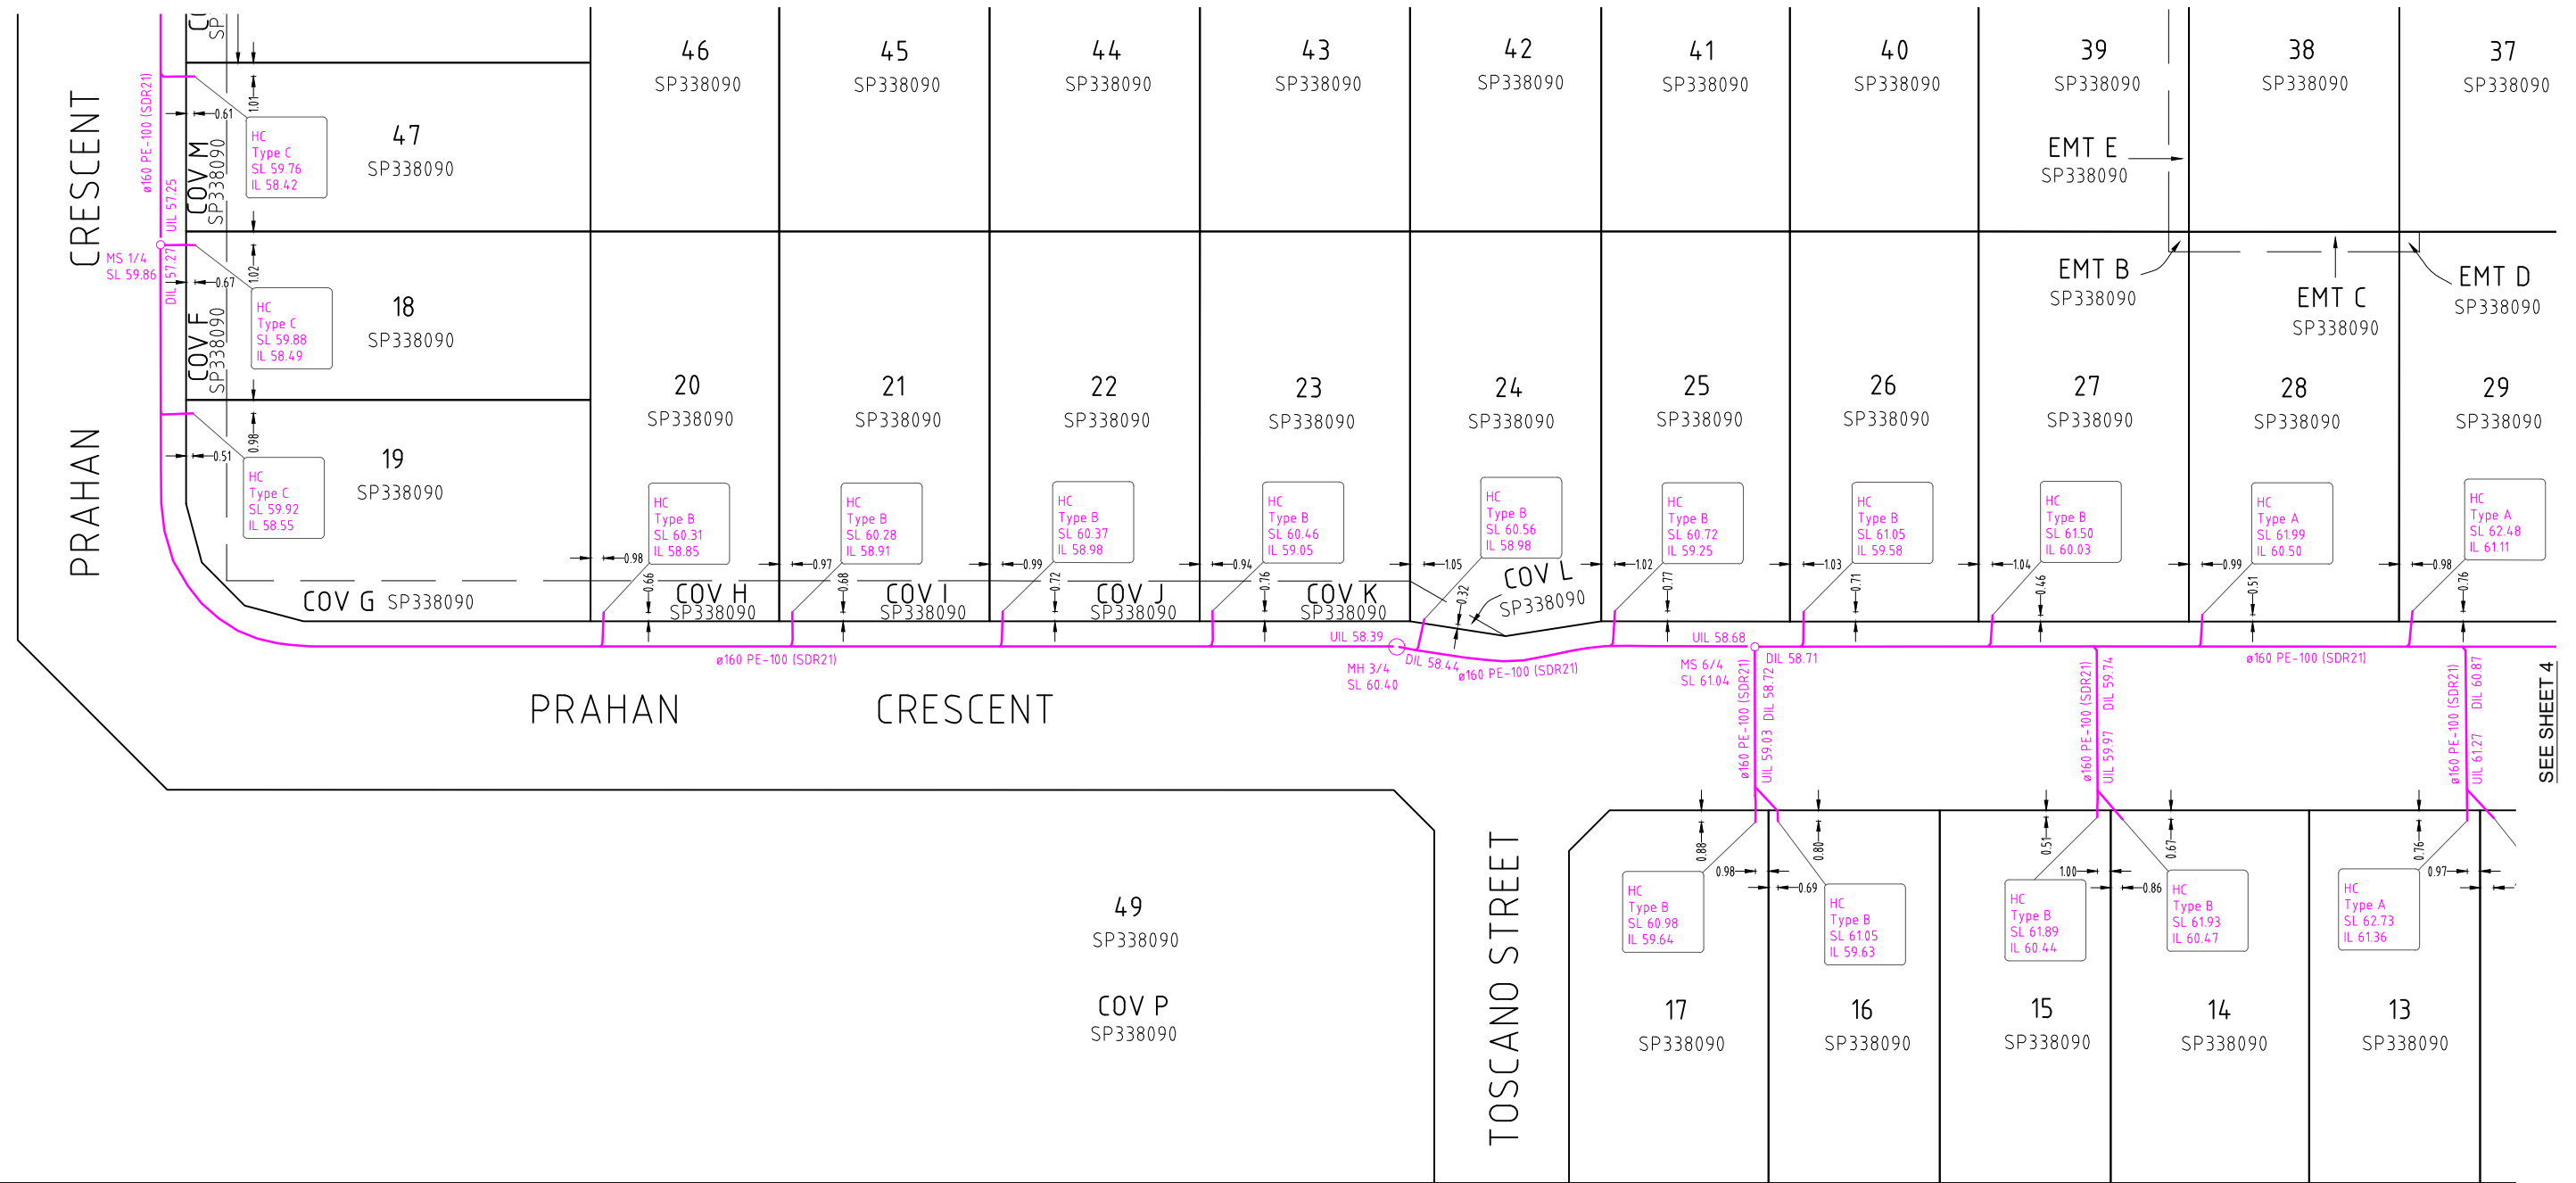

SEE SHEET 4

All house connections are 110 unless otherwise noted.

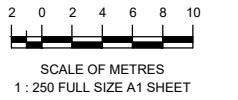

A1

REV NO	DATE	REVISION PURPOSE / DESCRIPTION	DRAWN	RPEQ	RPEQ No	INITIALS	DATE
A	18/10/2023	Builders Issue					

DRAWN	CM	06.10.2023
CHECKED	JL	11.10.2023
APPROVED		

SH saunders havill group
 Saunders Havill Group Pty Ltd ABN 24 144 592 540
 head office 9 Thompson St Bowen Hills Q 4006
 phone 090 433 5142 web www.saundershavill.com
 ■ surveying ■ town planning ■ urban design ■ environmental management ■ landscape architecture
 Drawing No: 11200 S 04 AC A



ADORA ESTATE
 BEAUDESERT ROAD, PARKINSON
 PLAN OF ADAC SURVEY DATA
 SEWERAGE RETICULATION 22-PNT-61795

DRAWING STATUS AS CONSTRUCTED	
SHEET 2 OF 5 SHEETS	
DRAWING NO.	REV. A


All house connections are Ø110 unless otherwise noted.



SEE SHEET 1
CRESCENT
PRAHAN

SEE SHEET 5

SEE SHEET 2

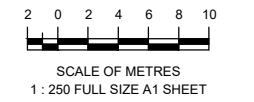

A1

REV NO	DATE	REVISION PURPOSE / DESCRIPTION	DRAWN	RPEQ	RPEQ No
A	18/10/2023	Builders Issue			


DRAWN	CM	06.10.2023
CHECKED	JL	11.10.2023
APPROVED		

saunders havill group
 Saunders Havill Group Pty Ltd ABN 24 144 592 540
 head office 5 Thompson St Bowen Hills Q 4006
 phone 090 83 5HG web www.saundershavill.com
 ■ surveying ■ town planning ■ urban design ■ environmental management ■ landscape architecture
 Drawing No: 11200 S 04 AC A



ADORA ESTATE
 BEAUDESERT ROAD, PARKINSON
 PLAN OF ADAC SURVEY DATA
 SEWERAGE RETICULATION 22-PNT-61795


DRAWING STATUS AS CONSTRUCTED	
SHEET 3 OF 5 SHEETS	
DRAWING NO.	REV.
	A

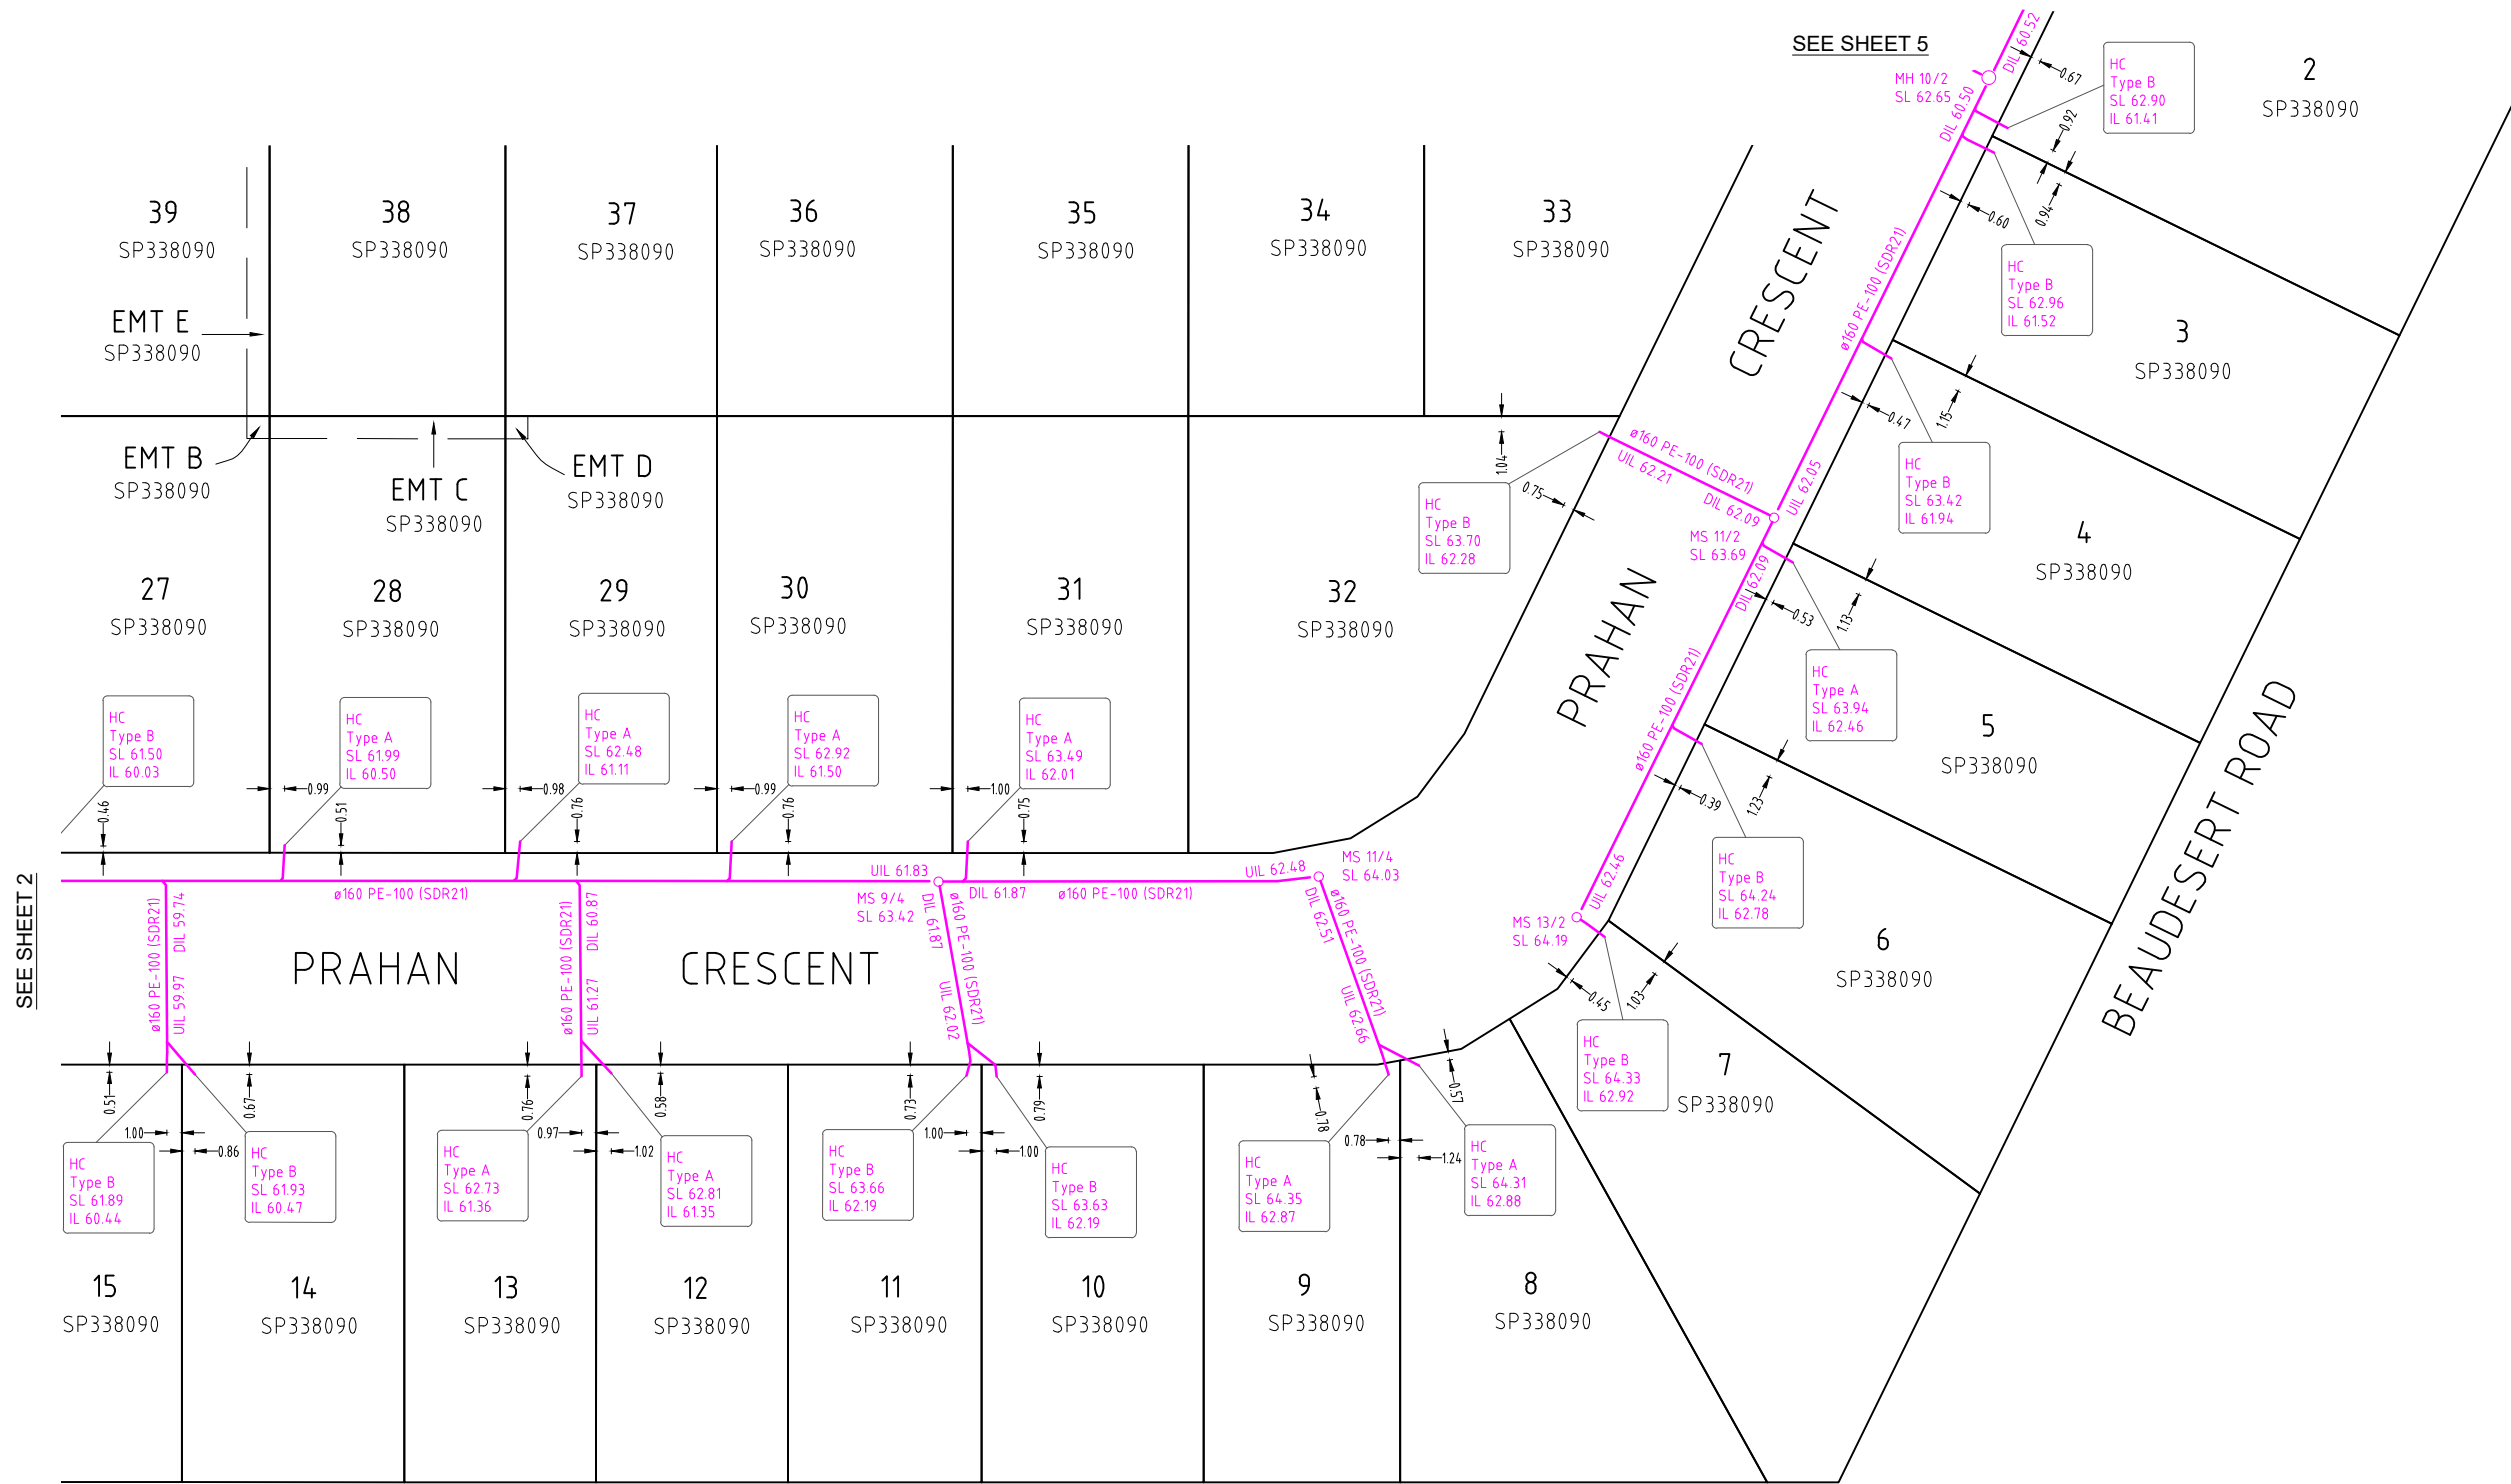

SEE SHEET 2

SEE SHEET 5

All house connections are 110 unless otherwise noted.

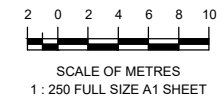

A1

REV NO	DATE	REVISION PURPOSE / DESCRIPTION	DRAWN	RPEQ	RPEQ No
A	18/10/2023	Builders Issue			

DRAWN	CM	06.10.2023
CHECKED	JL	11.10.2023
APPROVED		

SH saunders havill group
 Saunders Havill Group Pty Ltd ABN 24 144 592 540
 head office 9 Thompson St Bowen Hills Q 4006
 phone 090 433 5142 web www.saundershavill.com
 ■ surveying ■ town planning ■ urban design ■ environmental management ■ landscape architecture



ADORA ESTATE
 BEAUDESERT ROAD, PARKINSON
 PLAN OF ADAC SURVEY DATA
 SEWERAGE RETICULATION 22-PNT-61795


DRAWING STATUS AS CONSTRUCTED	
SHEET 4 OF 5 SHEETS	
DRAWING NO.	REV. A

Drawing No: 11200 S 04 AC A




SEE SHEET 3

SEE SHEET 4

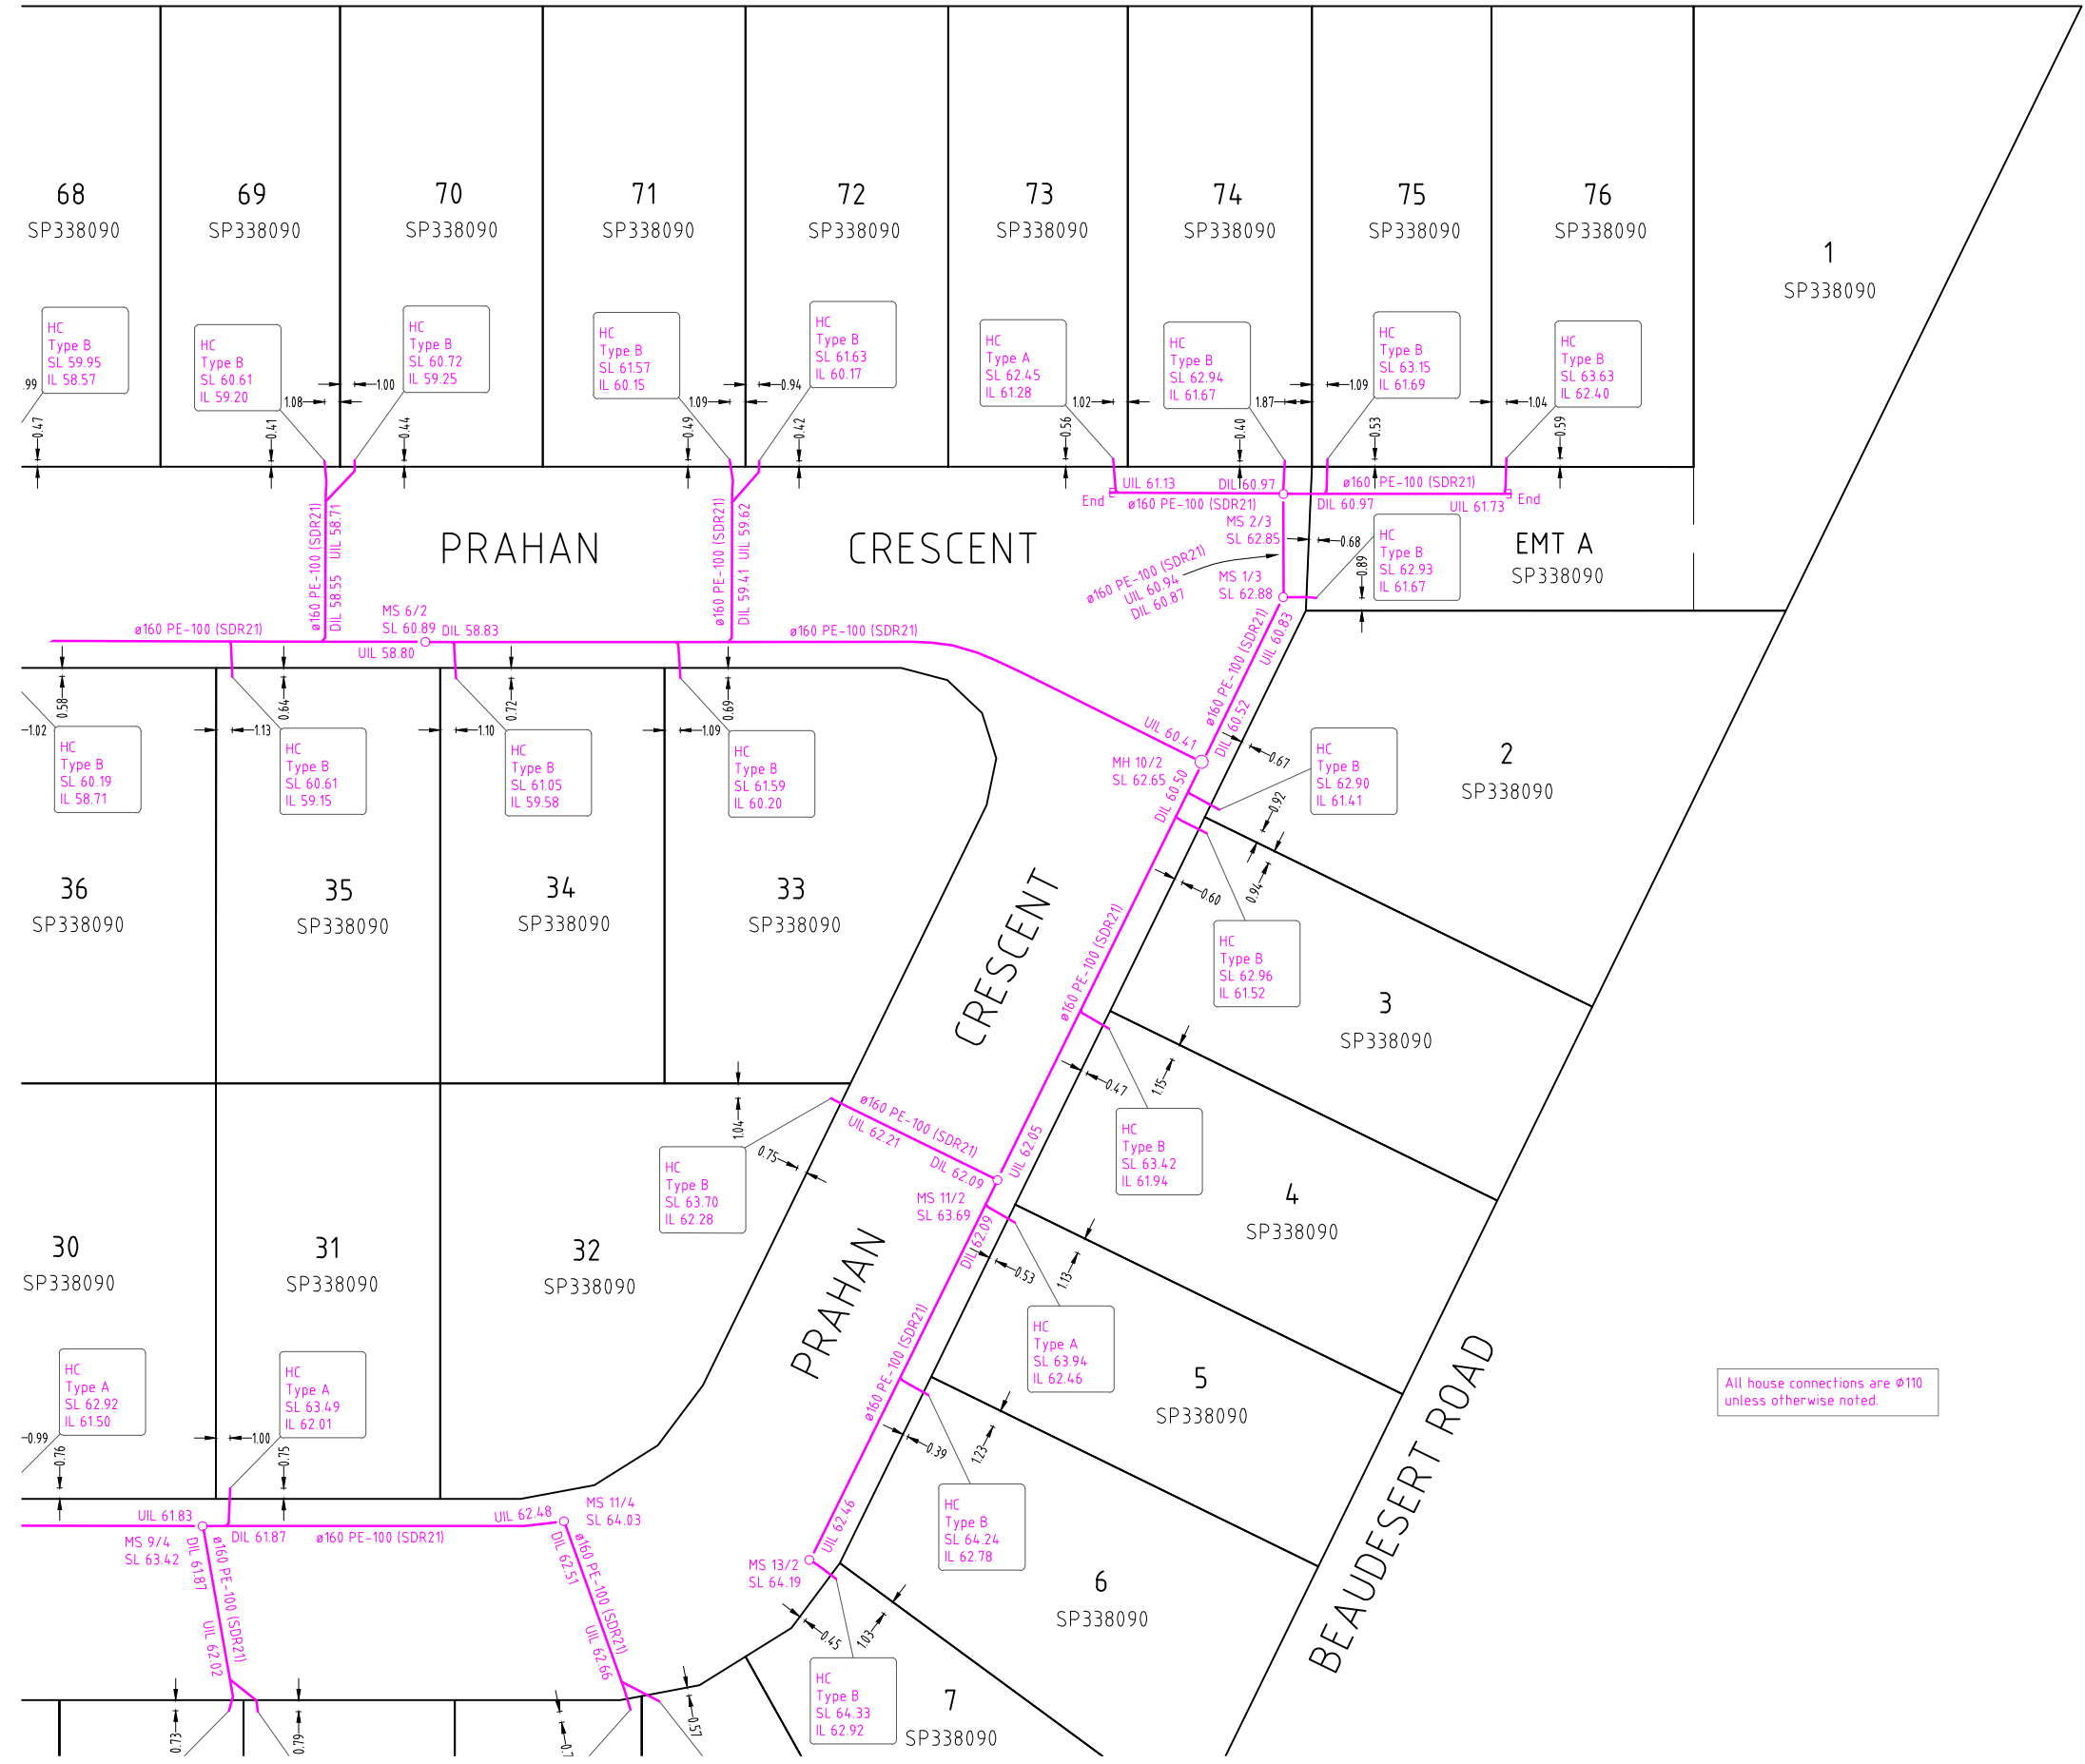

All house connections are $\phi 110$ unless otherwise noted.

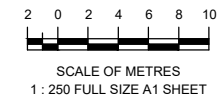

A1

REV NO	DATE	REVISION PURPOSE / DESCRIPTION	DRAWN	RPEQ	RPEQ No
A	18/10/2023	Builders Issue			

DRAWN	CM	06.10.2023
CHECKED	JL	11.10.2023
APPROVED		


SH saunders havill group
 Saunders Havill Group Pty Ltd ABN 54 144 592 540
 head office 9 Thompson St Bowen Hills Q 4006
 phone 090 433 5142 web www.saundershavill.com
 ■ surveying ■ town planning ■ urban design ■ environmental management ■ landscape architecture

Drawing No: 11200 S 04 AC A



ADORA ESTATE
 BEAUDESERT ROAD, PARKINSON
 PLAN OF ADAC SURVEY DATA
 SEWERAGE RETICULATION 22-PNT-61795

DRAWING STATUS AS CONSTRUCTED	
SHEET 5 OF 5 SHEETS	
DRAWING NO.	REV.
	A

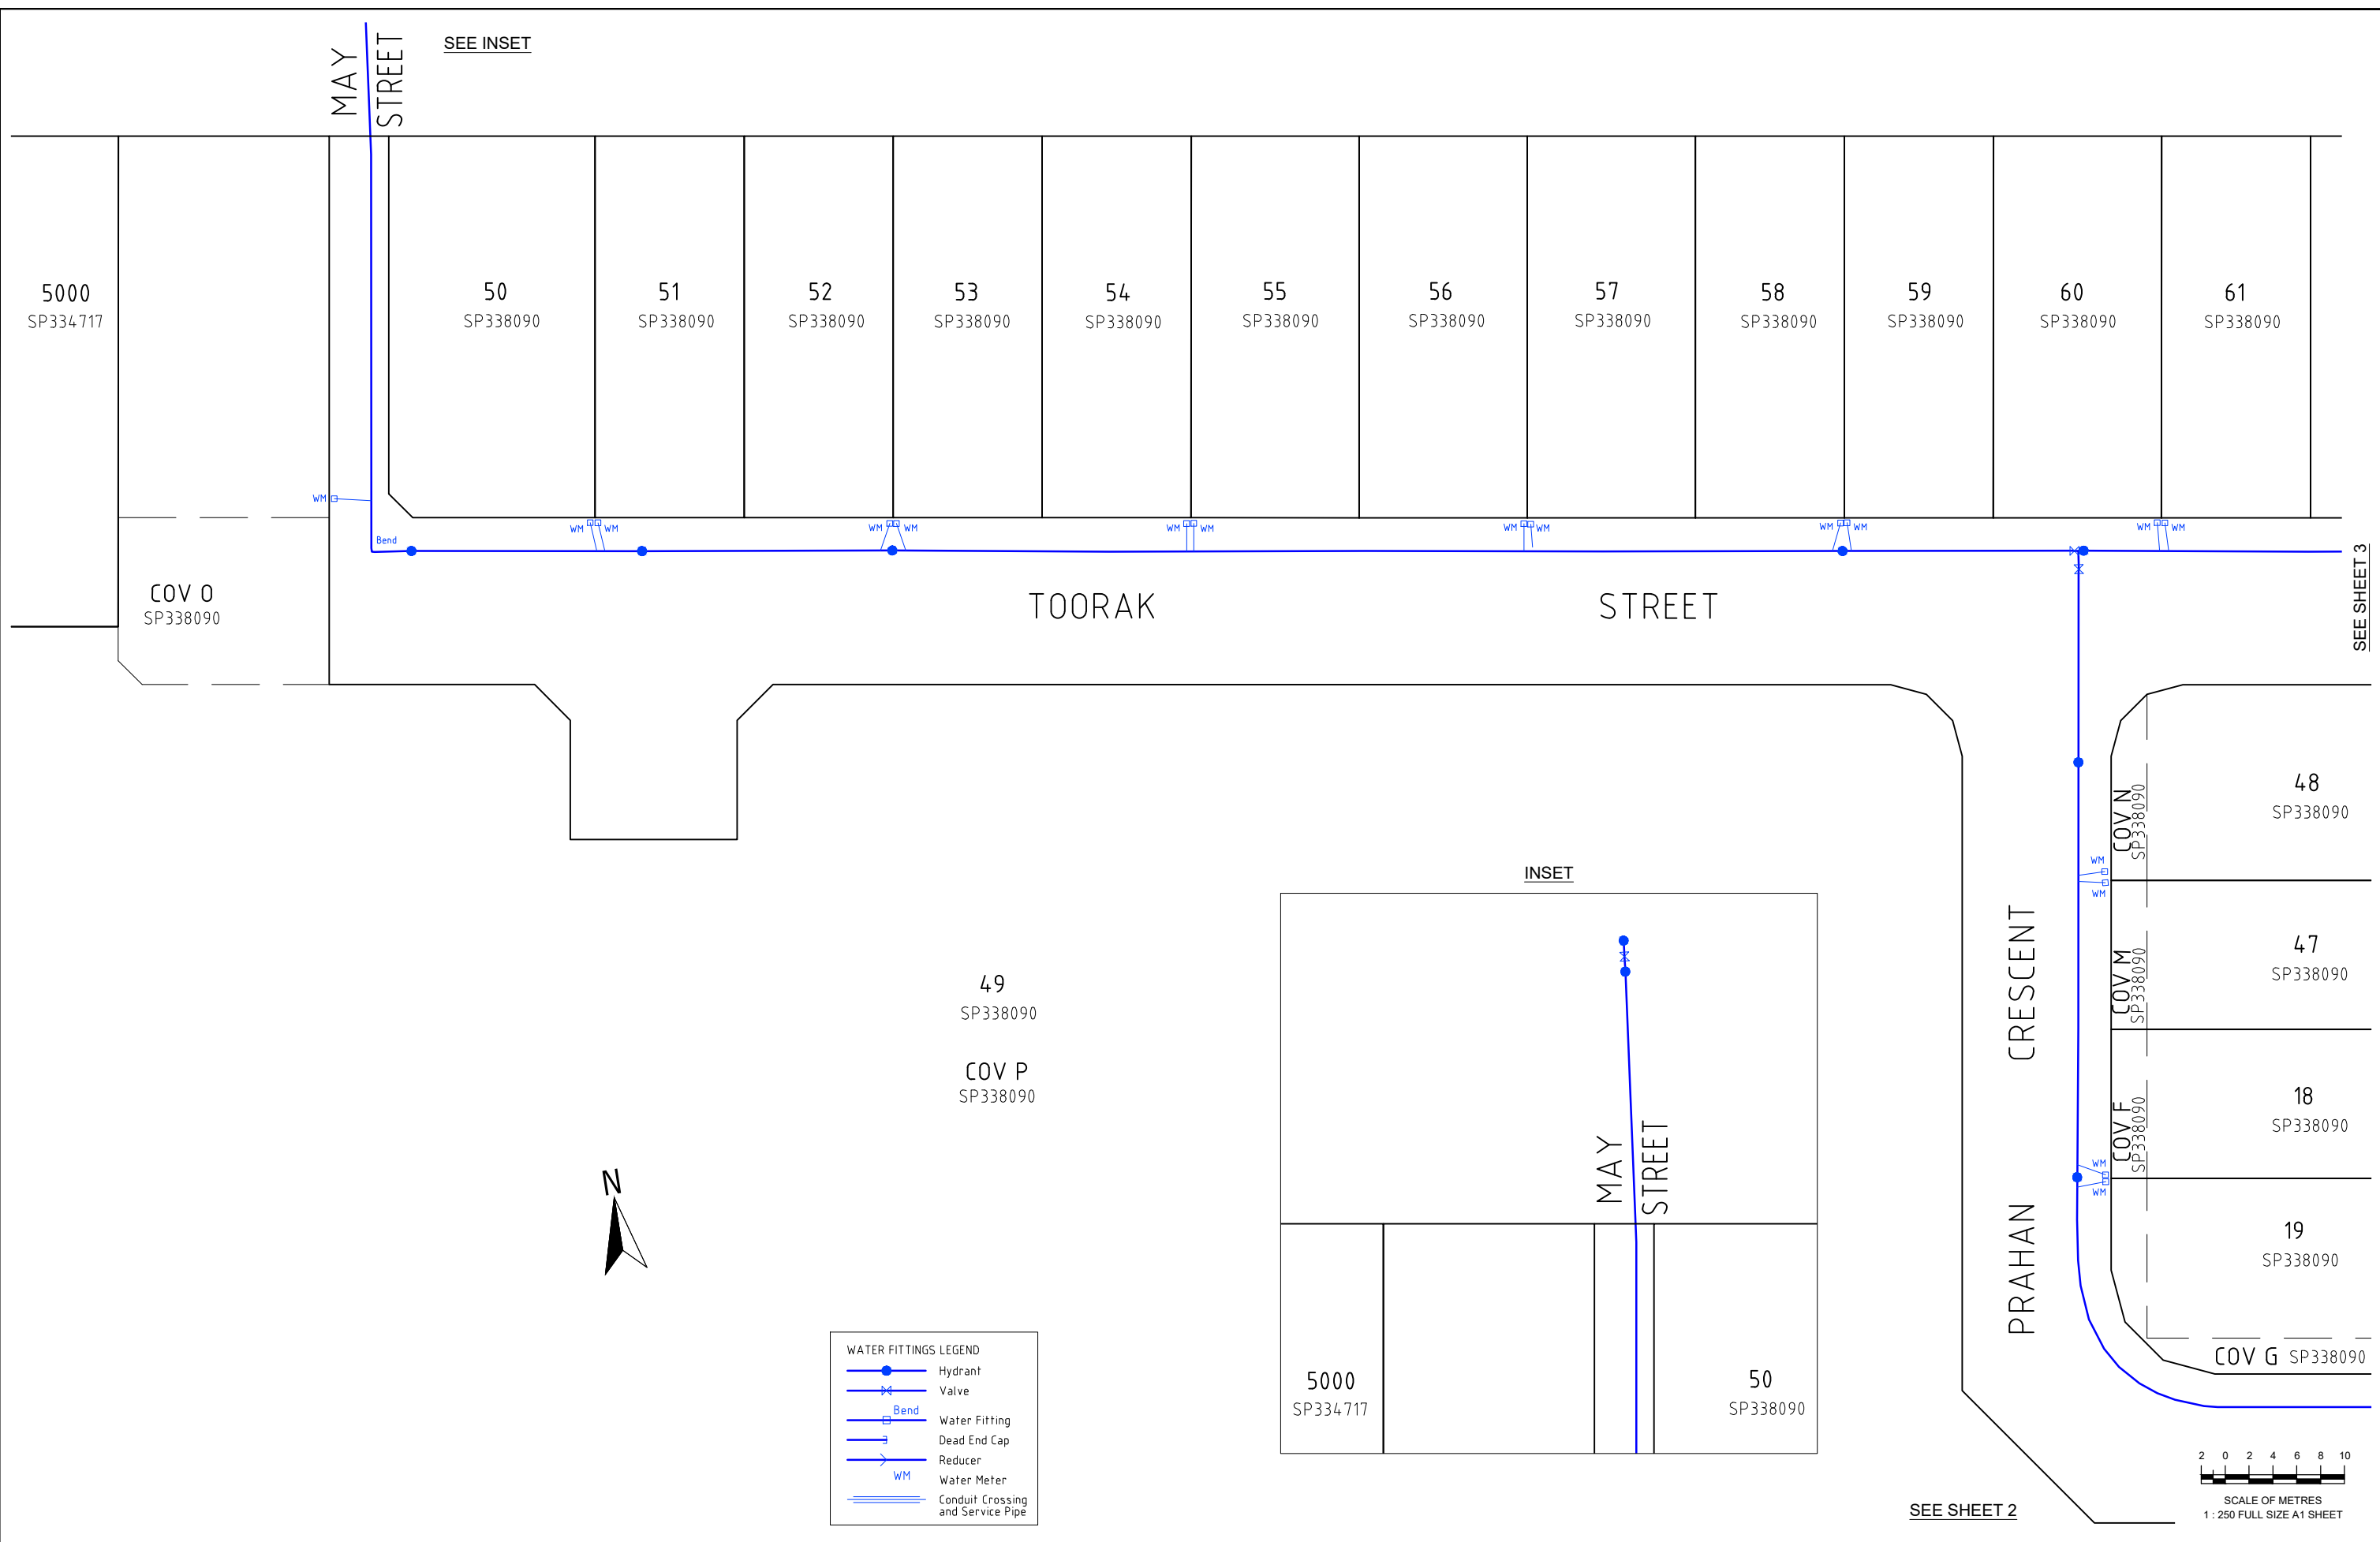

WATER FITTINGS LEGEND

	Hydrant
	Valve
	Bend
	Water Fitting
	Dead End Cap
	Reducer
	Water Meter
	Conduit Crossing and Service Pipe

A1	REV NO	DATE	REVISION PURPOSE / DESCRIPTION	DRAWN	RPEQ	RPEQ No	DRAWN	INITIALS	DATE
	A	18/10/2023	Builders Issue						

DRAWN	CM	06.10.2023
CHECKED	JL	11.10.2023
APPROVED		



ADORA ESTATE
BEAUDESERT ROAD, PARKINSON


PLAN OF ADAC SURVEY DATA
WATER RETICULATION 22-PNT-61795

DRAWING STATUS AS CONSTRUCTED	
SHEET 1 OF 5 SHEETS	
DRAWING NO.	REV.
	A


Drawing No: 11200 S 04 AC A



SEE SHEET 1

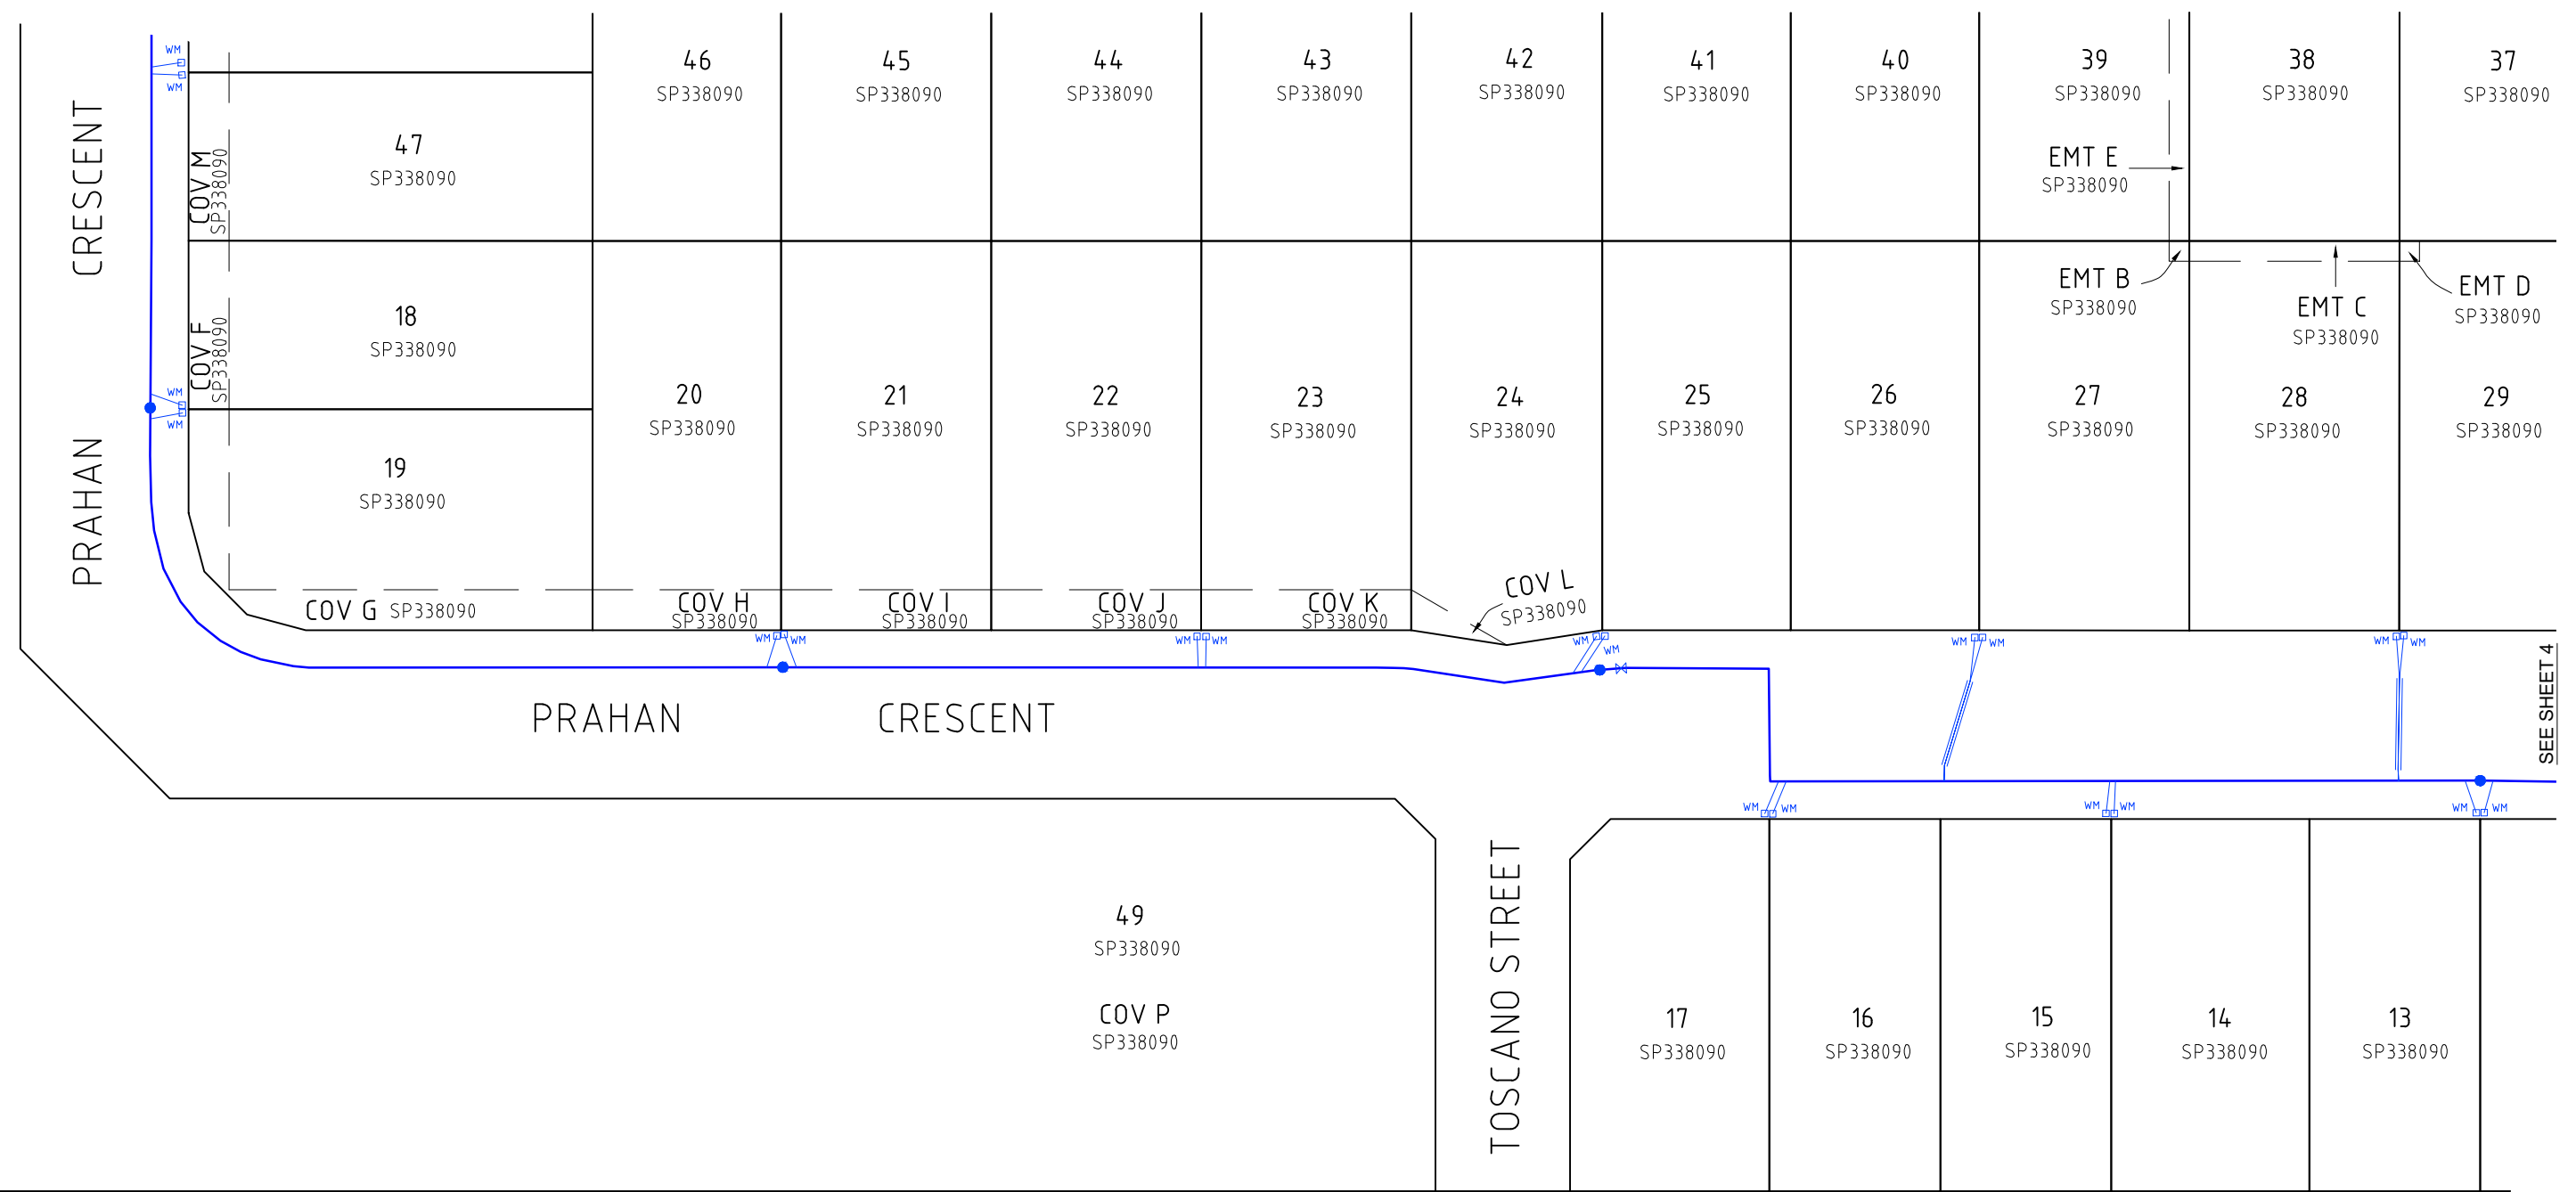

WATER FITTINGS LEGEND	
	Hydrant
	Valve
	Bend
	Water Fitting
	Dead End Cap
	Reducer
	Water Meter
	Conduit Crossing and Service Pipe

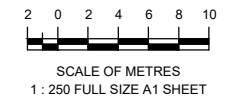

A1

REV NO	DATE	REVISION PURPOSE / DESCRIPTION	DRAWN	RPEQ	RPEQ No
A	18/10/2023	Builders Issue			

DRAWN	CM	06.10.2023
CHECKED	JL	11.10.2023
APPROVED		


SH saunders havill group
 Saunders Havill Group Pty Ltd ABN 24 144 572 540
 head office 5 Thompson St Bowen Hills Q 4006
 phone: 090 453 5142 web: www.saundershavill.com
 ■ surveying ■ town planning ■ urban design ■ environmental management ■ landscape architecture



ADORA ESTATE
 BEAUDESERT ROAD, PARKINSON
 PLAN OF ADAC SURVEY DATA
 WATER RETICULATION 22-PNT-61795

DRAWING STATUS	
AS CONSTRUCTED	
SHEET 2 OF 5 SHEETS	
DRAWING NO.	REV.
	A

Drawing No: 11200 S 04 AC A

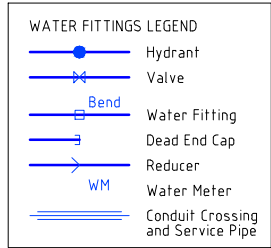

A1

REV NO	DATE	REVISION PURPOSE / DESCRIPTION	DRAWN	RPEQ	RPEQ No	INITIALS	DATE
A	18/10/2023	Builders Issue					

DRAWN	CM	06.10.2023
CHECKED	JL	11.10.2023
APPROVED		

SH saunders havill group
 Saunders Havill Group Pty Ltd ABN 24 144 572 540
 head office 9 Thompson St Bowen Hills Q 4006
 phone: 0900 633 5142 web: www.saundershavill.com
 ■ surveying ■ town planning ■ urban design ■ environmental management ■ landscape architecture

Drawing No: 11200 S 04 AC A




ADORA ESTATE
BEAUDESERT ROAD, PARKINSON
PLAN OF ADAC SURVEY DATA
WATER RETICULATION 22-PNT-61795

DRAWING STATUS	
AS CONSTRUCTED	
SHEET 3 OF 5 SHEETS	
DRAWING NO.	REV.
	A




SEE SHEET 5

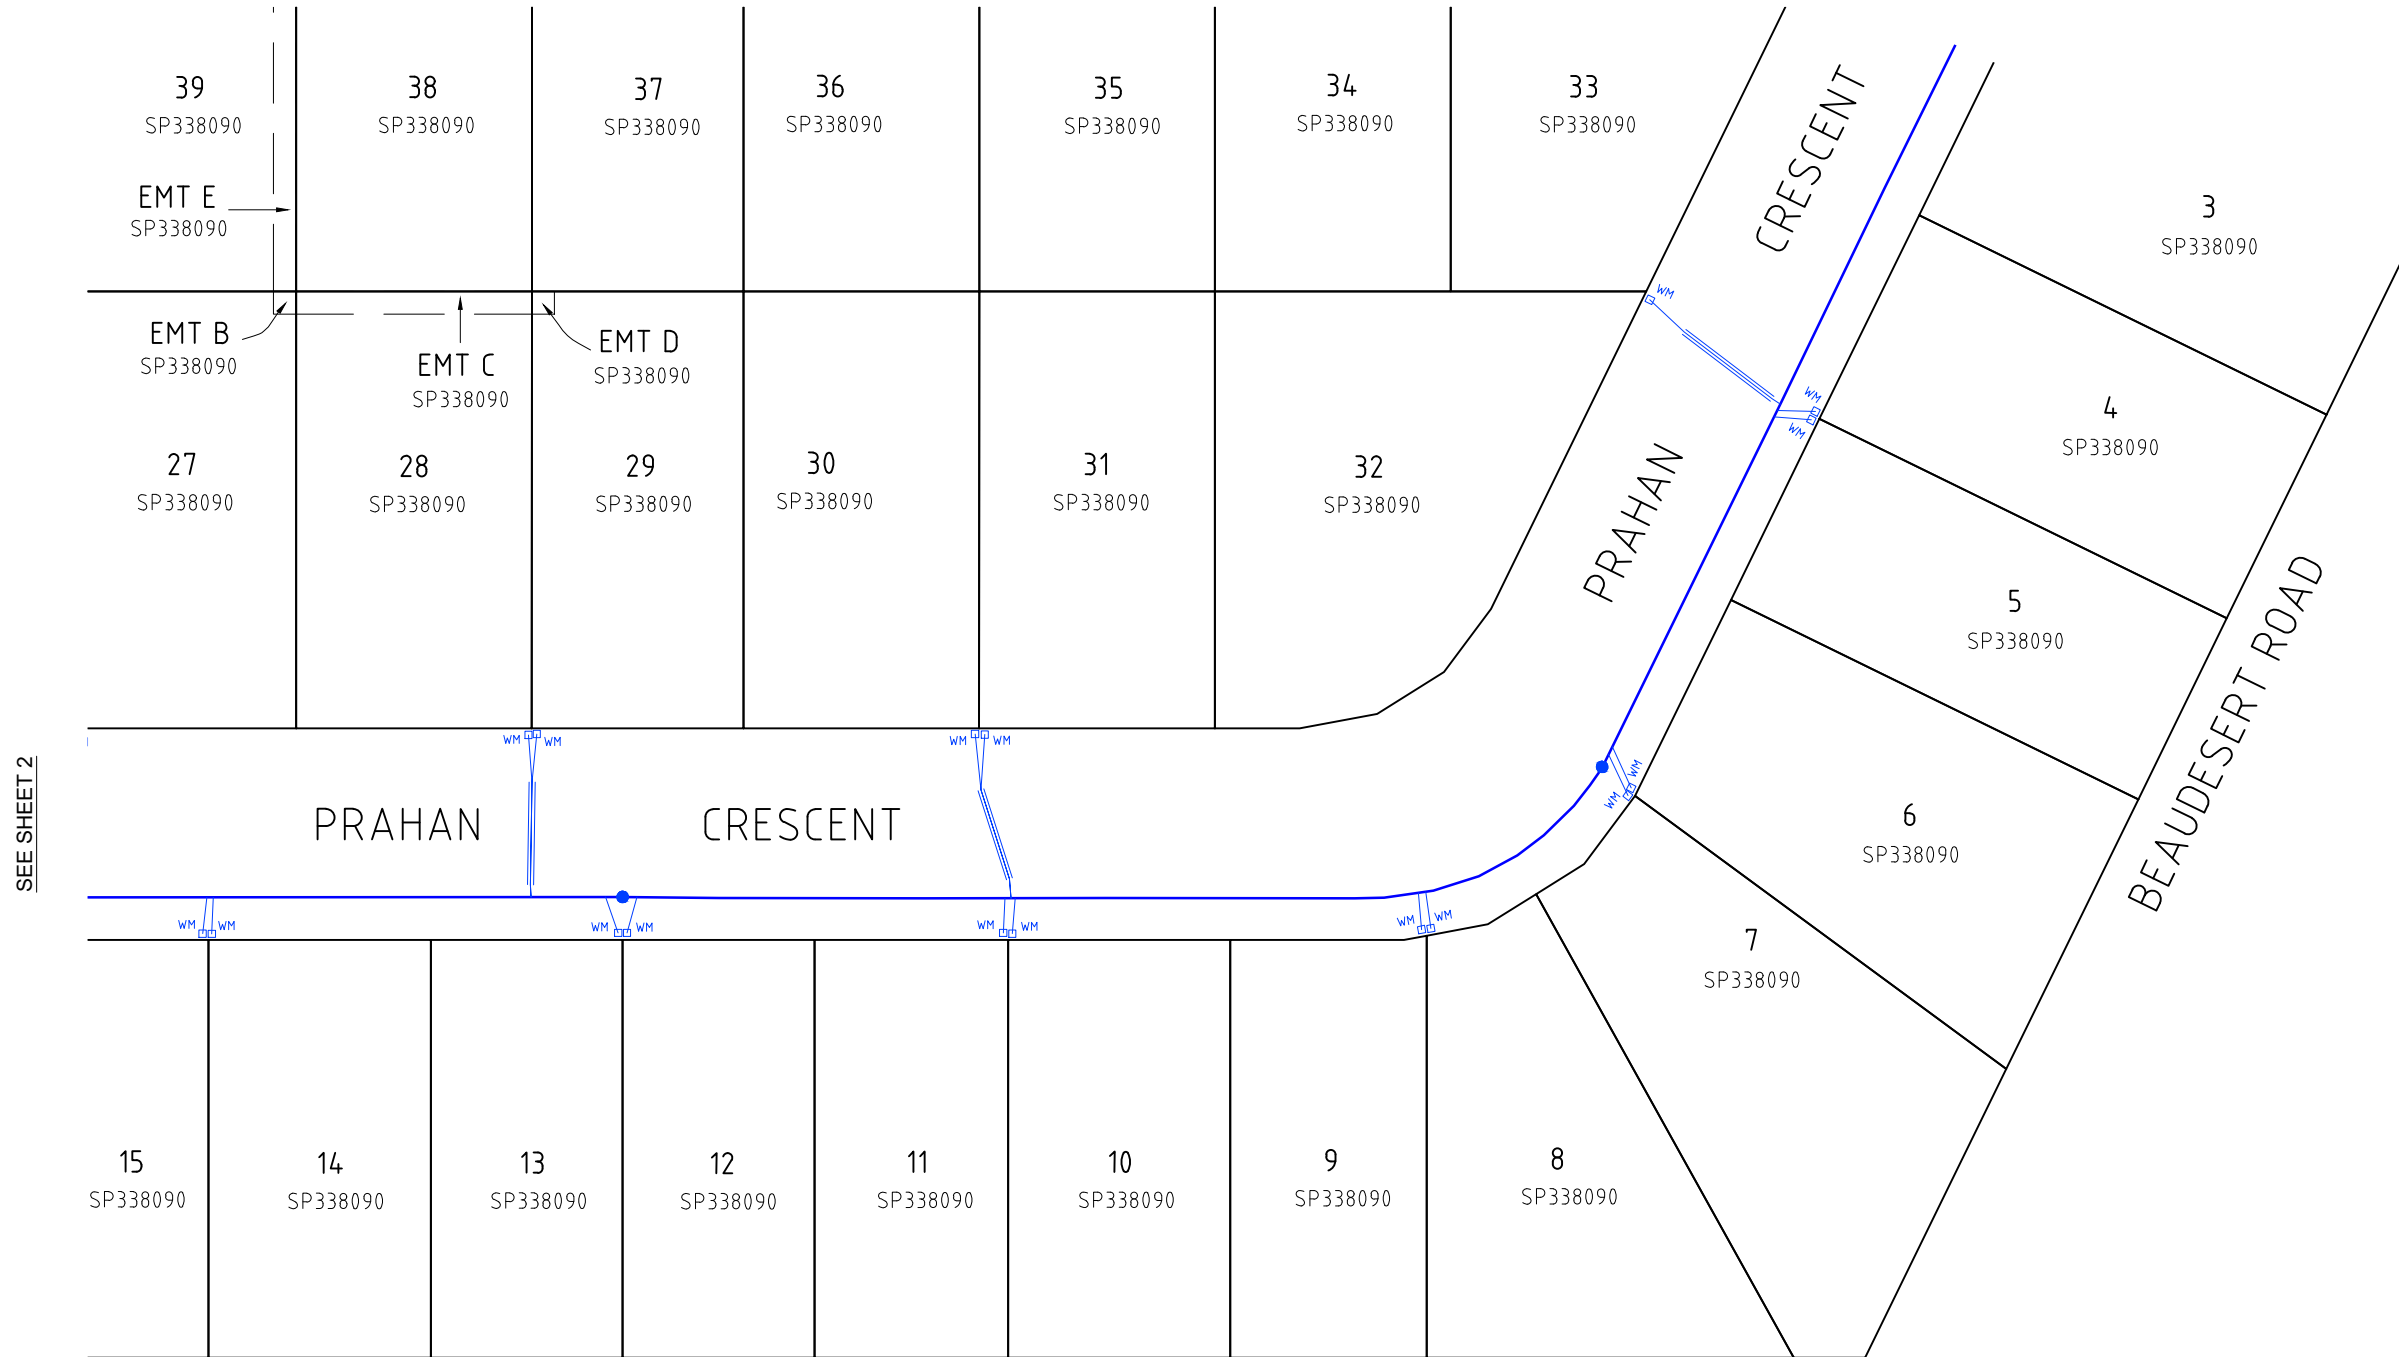

SEE SHEET 2

WATER FITTINGS LEGEND	
	Hydrant
	Valve
	Bend
	Water Fitting
	Dead End Cap
	Reducer
	Water Meter
	Conduit Crossing and Service Pipe

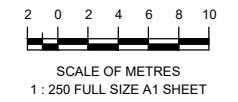

A1

REV NO	DATE	REVISION PURPOSE / DESCRIPTION	DRAWN	RPEQ	RPEQ No
A	18/10/2023	Builders Issue			

DRAWN	CM	06.10.2023
CHECKED	JL	11.10.2023
APPROVED		


SH saunders havill group
 Saunders Havill Group Pty Ltd ABN 54 144 572 543
 head office 9 Thompson St Bowen Hills Q 4006
 phone: 0900 833 516 web: www.saundershavill.com
 ■ surveying ■ town planning ■ urban design ■ environmental management ■ landscape architecture



ADORA ESTATE
 BEAUDESERT ROAD, PARKINSON
 PLAN OF ADAC SURVEY DATA
 WATER RETICULATION 22-PNT-61795


DRAWING STATUS AS CONSTRUCTED	
SHEET 4 OF 5 SHEETS	
DRAWING NO.	REV. A

Drawing No: 11200 S 04 AC A

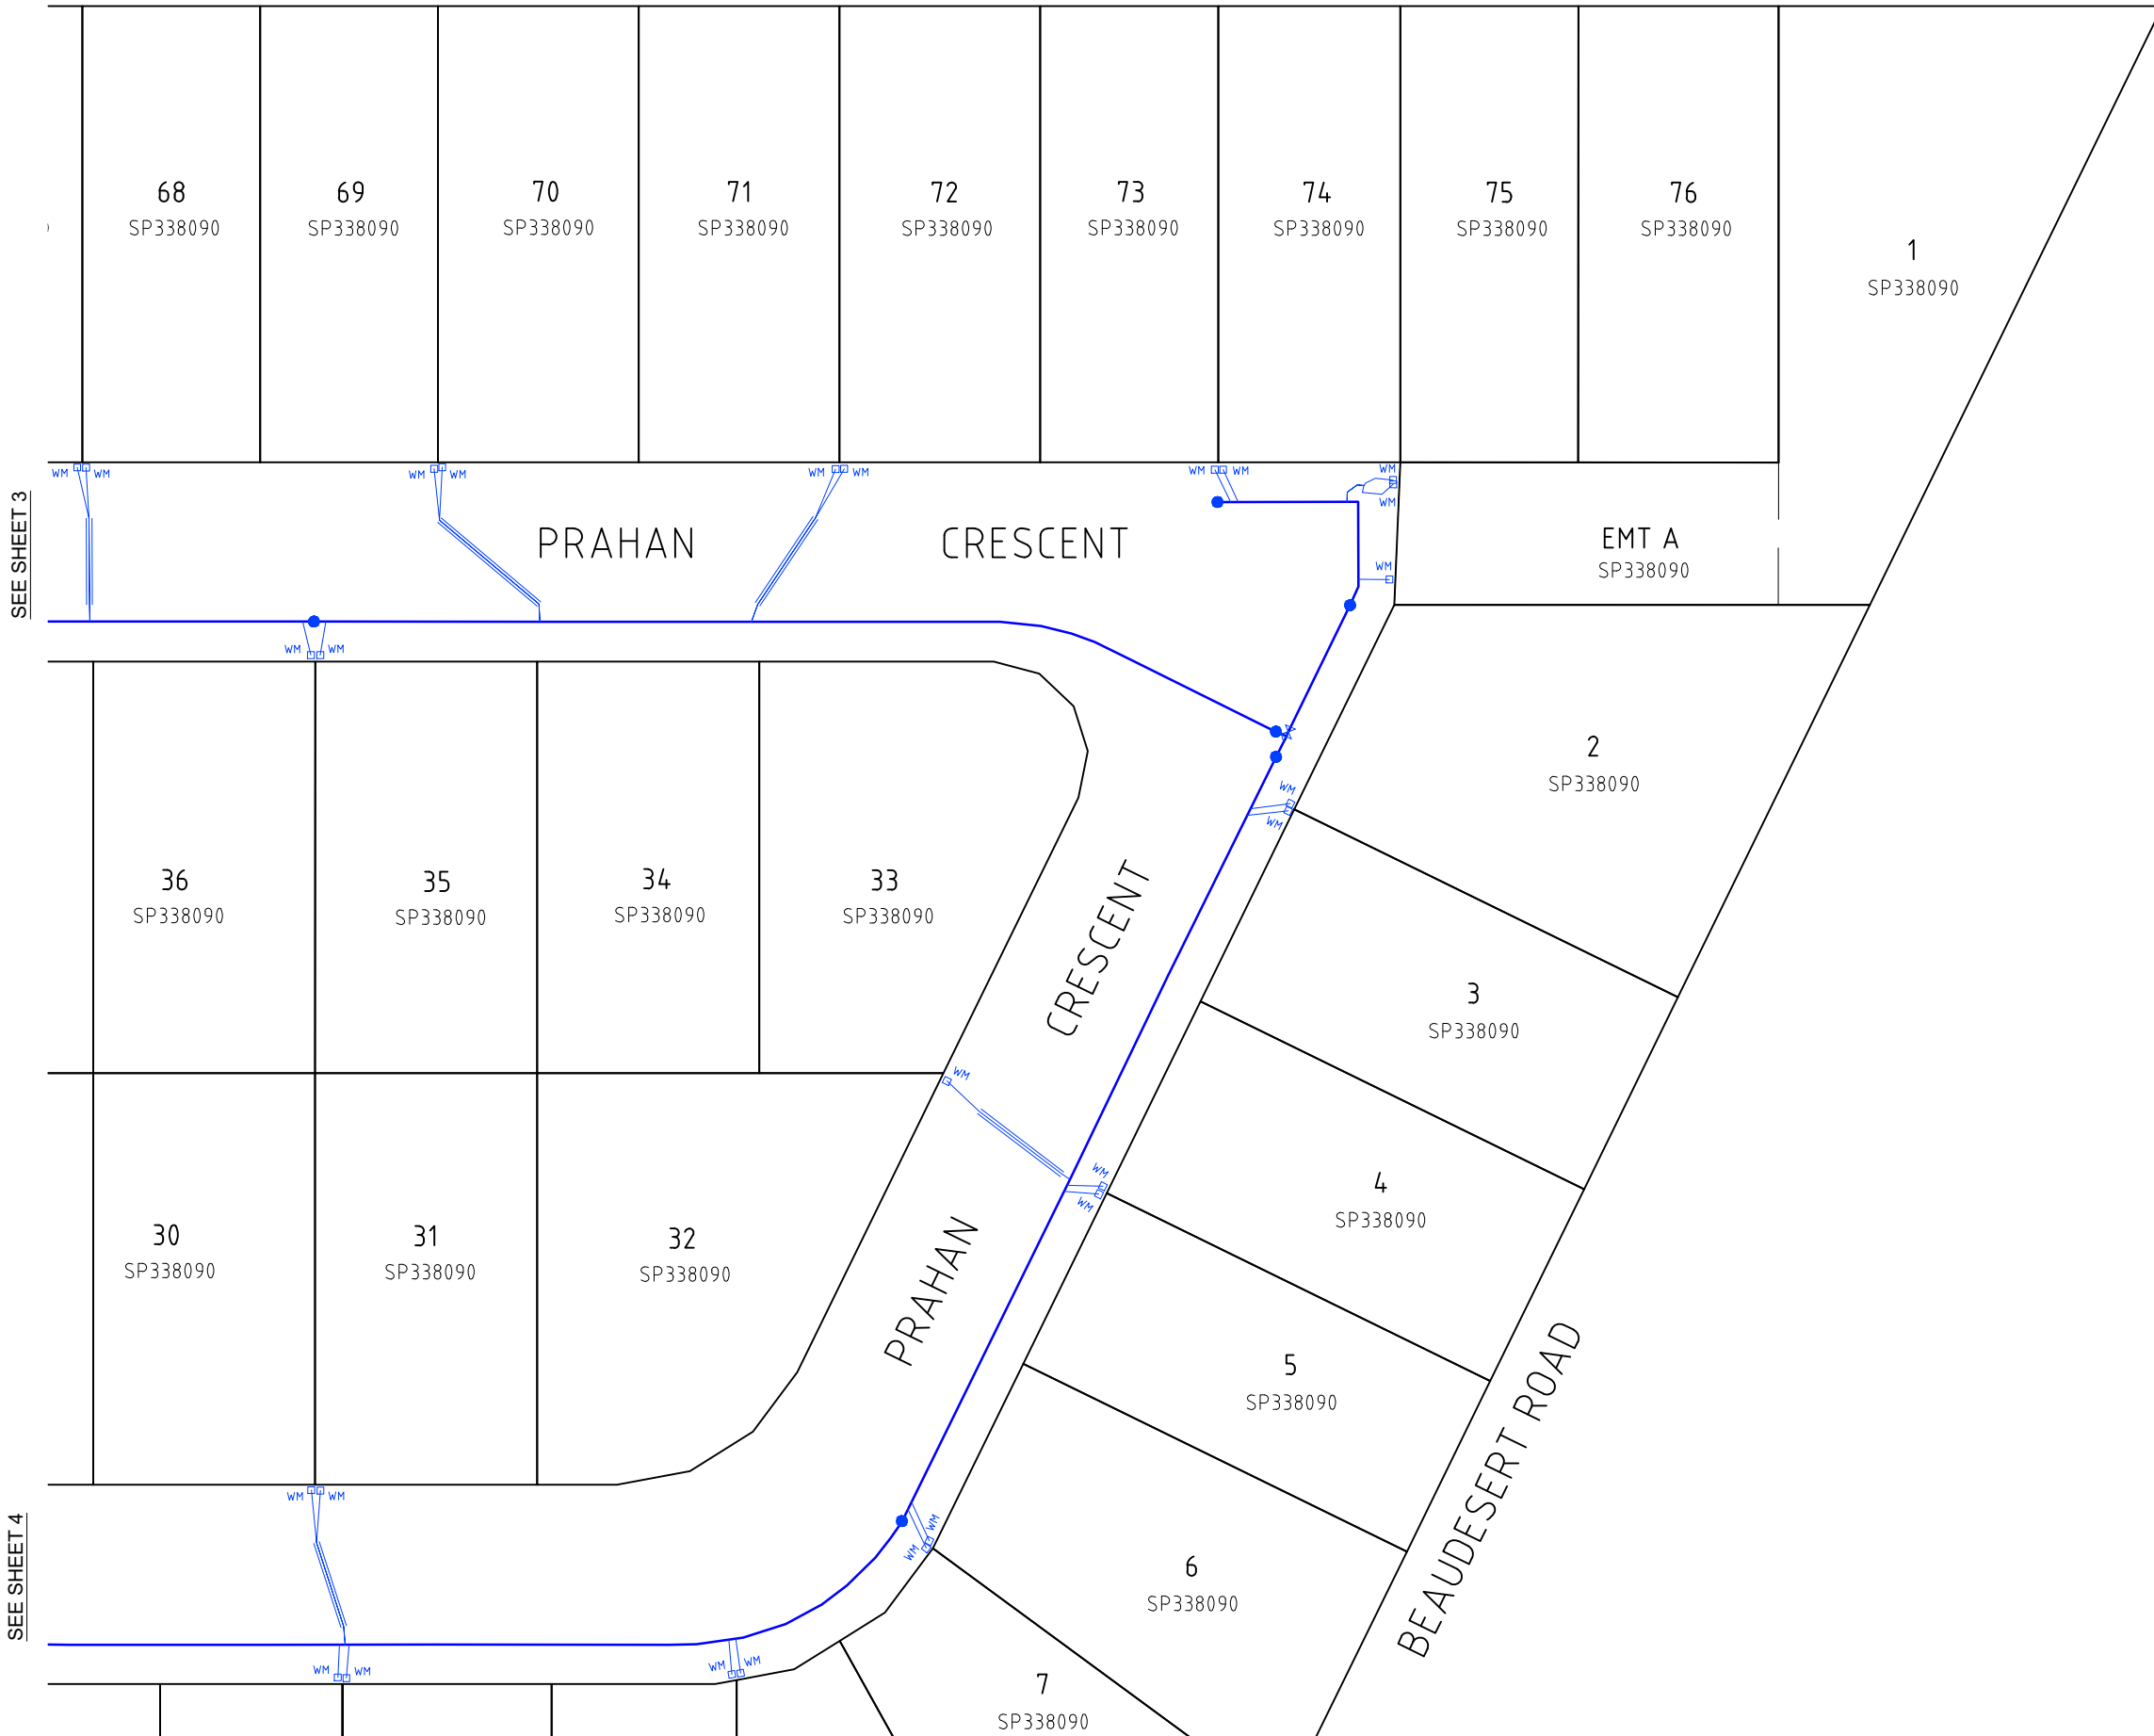

WATER FITTINGS LEGEND

- Hydrant
- Valve
- Bend
- Water Fitting
- Dead End Cap
- Reducer
- WM Water Meter
- Conduit Crossing and Service Pipe

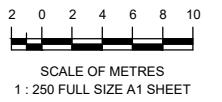

A1

REV NO	DATE	REVISION PURPOSE / DESCRIPTION	DRAWN	RPEQ	RPEQ No
A	18/10/2023	Builders Issue			

DRAWN	CM	06.10.2023
CHECKED	JL	11.10.2023
APPROVED		

SH saunders havill group
 Saunders Havill Group Pty Ltd ABN 24 144 572 543
 head office 5 Thompson St Bowen Hills Q 4006
 phone: 0800 623 514 web: www.saundershavill.com
 ■ surveying ■ town planning ■ urban design ■ environmental management ■ landscape architecture



**ADORA ESTATE
 BEAUDESERT ROAD, PARKINSON**

**PLAN OF ADAC SURVEY DATA
 WATER RETICULATION 22-PNT-61795**

DRAWING STATUS AS CONSTRUCTED	
SHEET 5 OF 5 SHEETS	
DRAWING NO.	REV. A

Drawing No: 11200 S 04 AC A