

AS CONSTRUCTED

SEE SHEET 2
SCALE 1:250

A1	INDEX	DATE	REVISIONS	DRAWN	CHECKED	PASSED
	A	18/10/2023	Builder's Issue			


DRAWN	CM	10/10/2023
CHECKED	JL	12/10/2023
PASSED		

SH saunders havill group
 Brisbane Springfield
 head office 9 Thompson St Bowen Hills Q 4006
 phone 1300 423 SHG web www.saundershavill.com
 Drawing No: 11200 S 05 AC A




BRISBANE CITY COUNCIL
 AS CONSTRUCTED - DRAINAGE
 ADORA ESTATE
 2875 BEAUDESERT ROAD, PARKINSON

SCALE	1:250
SHEET	1 OF 5 SHEETS
DRAWING NO.	

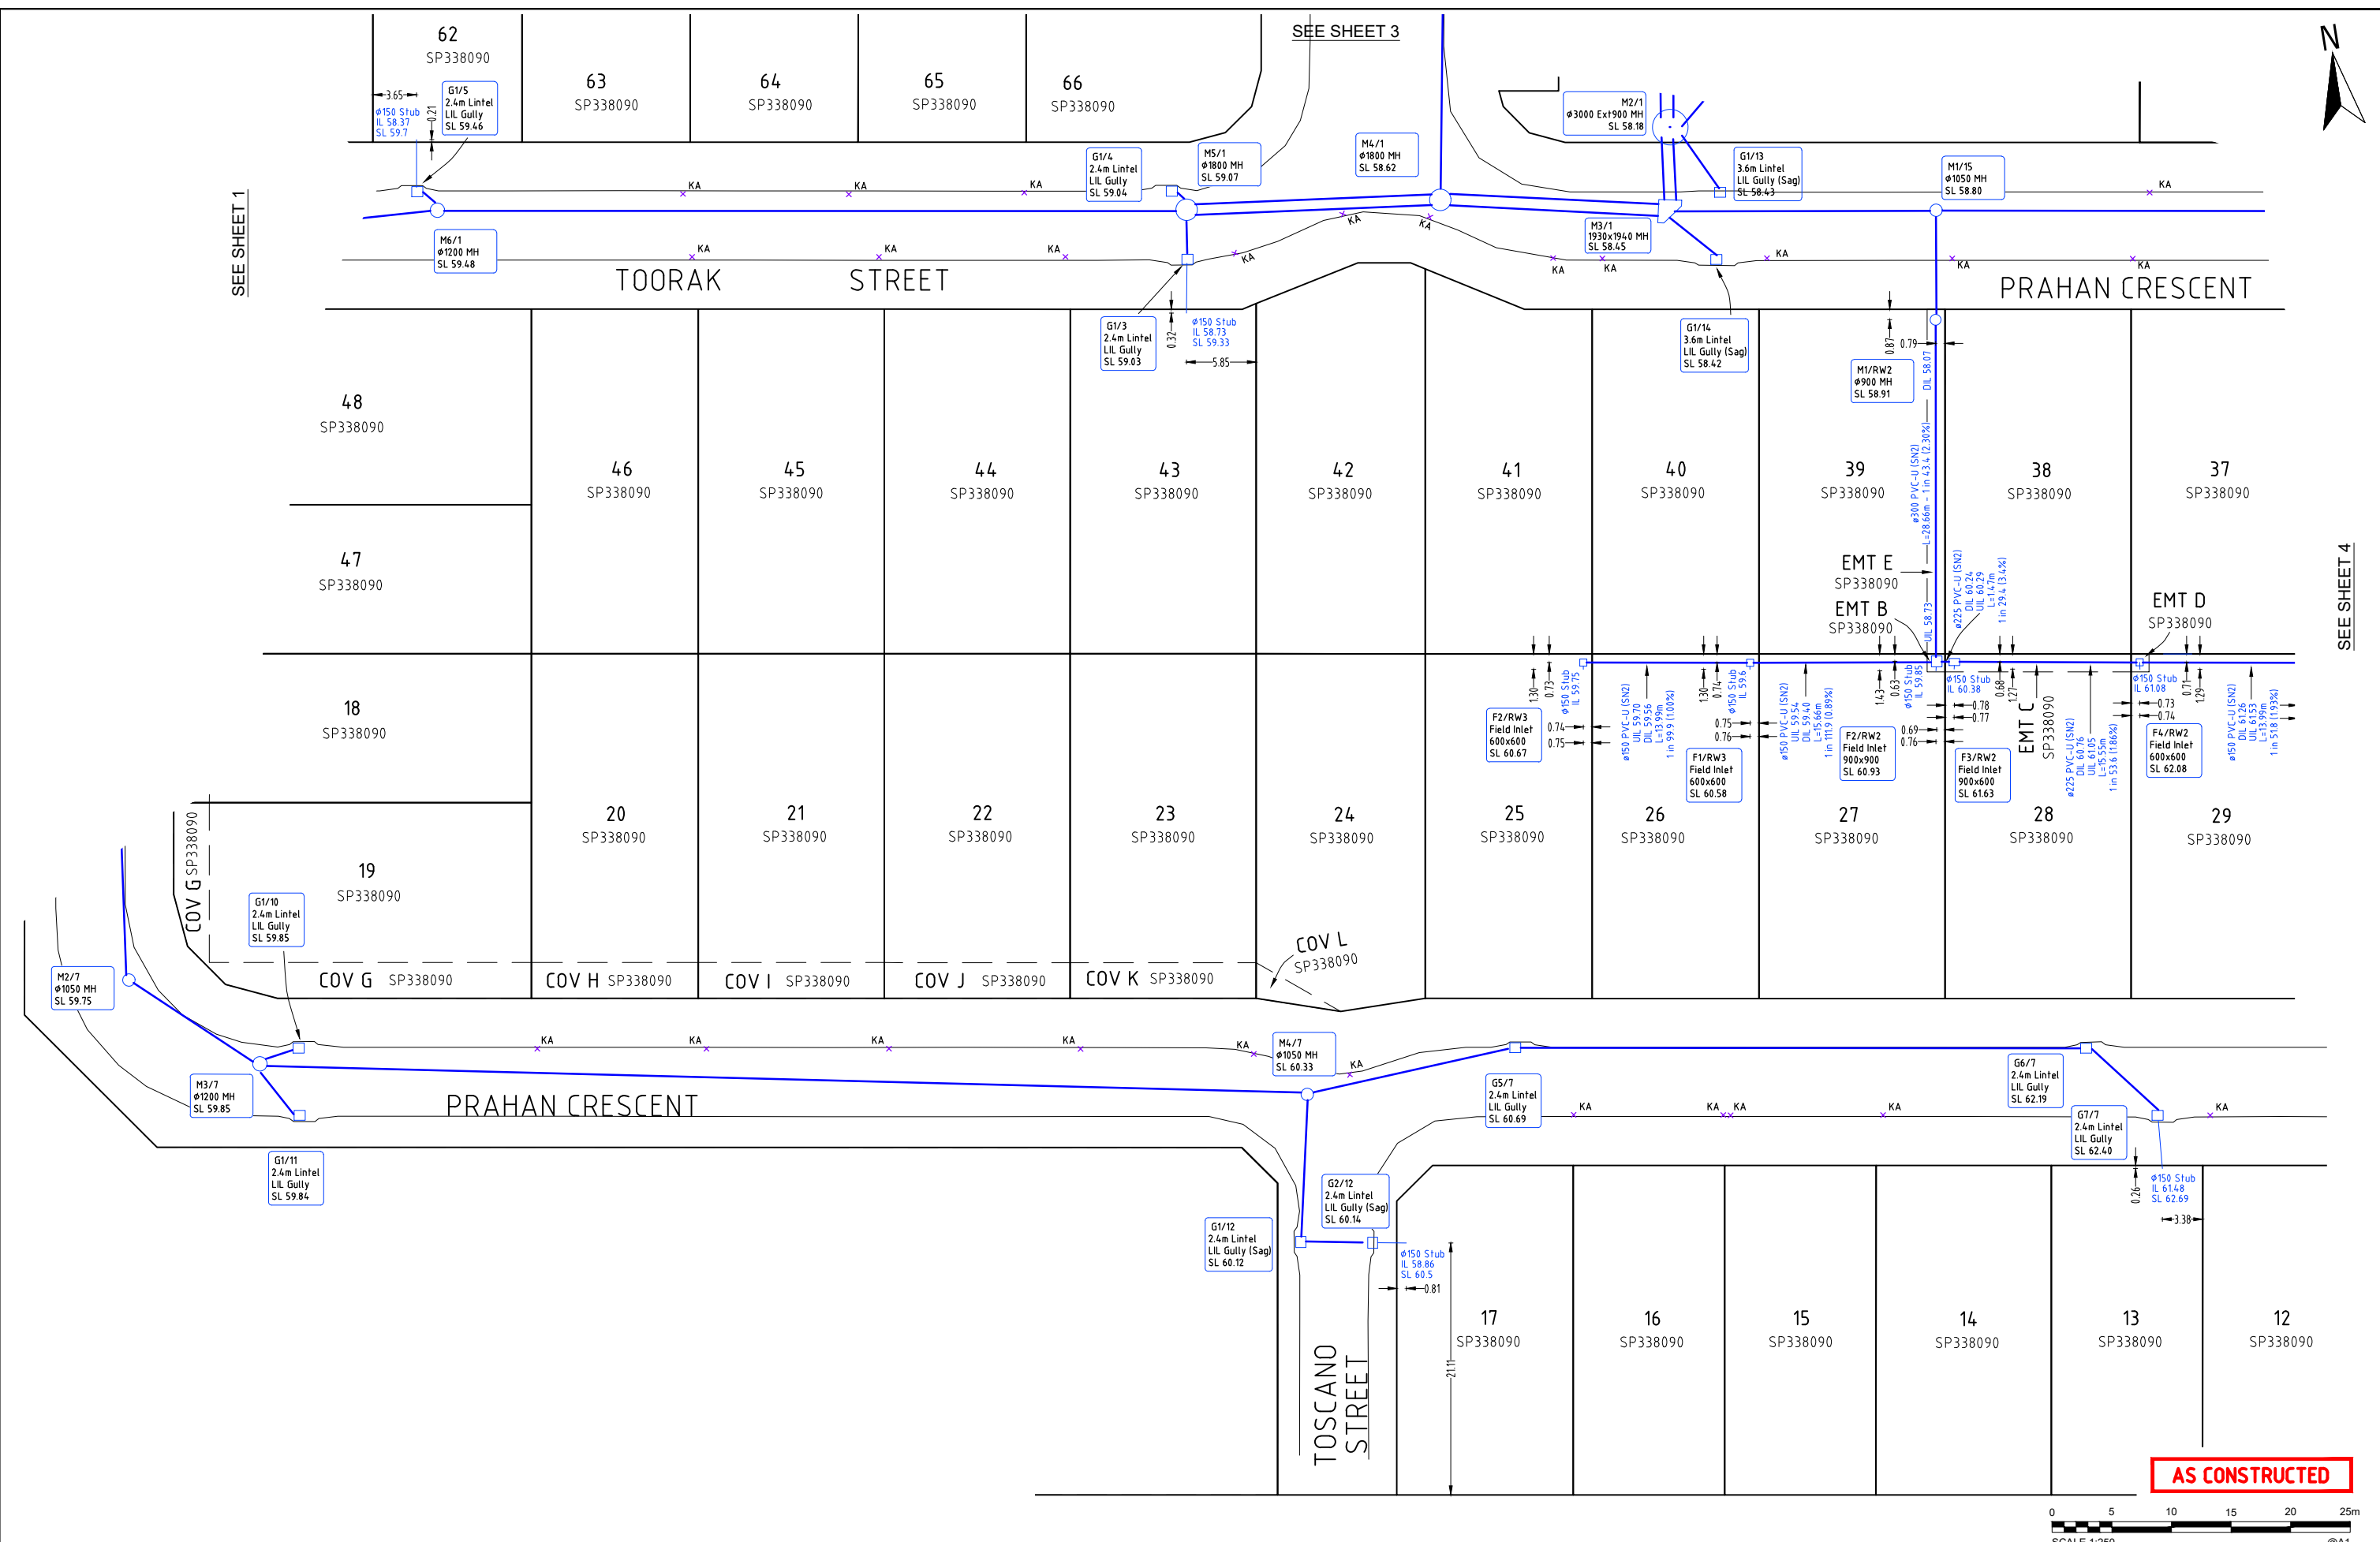


AS CONSTRUCTED

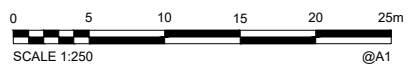

A1	INDEX	DATE	REVISIONS	DRAWN	CHECKED	PASSED
	A	18/10/2023	Builder's Issue			


DRAWN	CH	10/10/2023
CHECKED	JL	12/10/2023
PASSED		

saunders havill group
 Brisbane Springfield
 head office 9 Thompson St Bowen Hills Q 4006
 phone 1300 423 SHG web www.saundershavill.com
 Drawing No: 11200 S 05 AC A

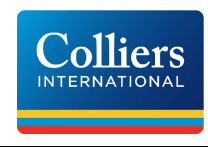


BRISBANE CITY COUNCIL
 AS CONSTRUCTED - DRAINAGE
 ADORA ESTATE
 2875 BEAUDESERT ROAD, PARKINSON

SCALE	1:250
SHEET	2 OF 5 SHEETS
DRAWING NO.	

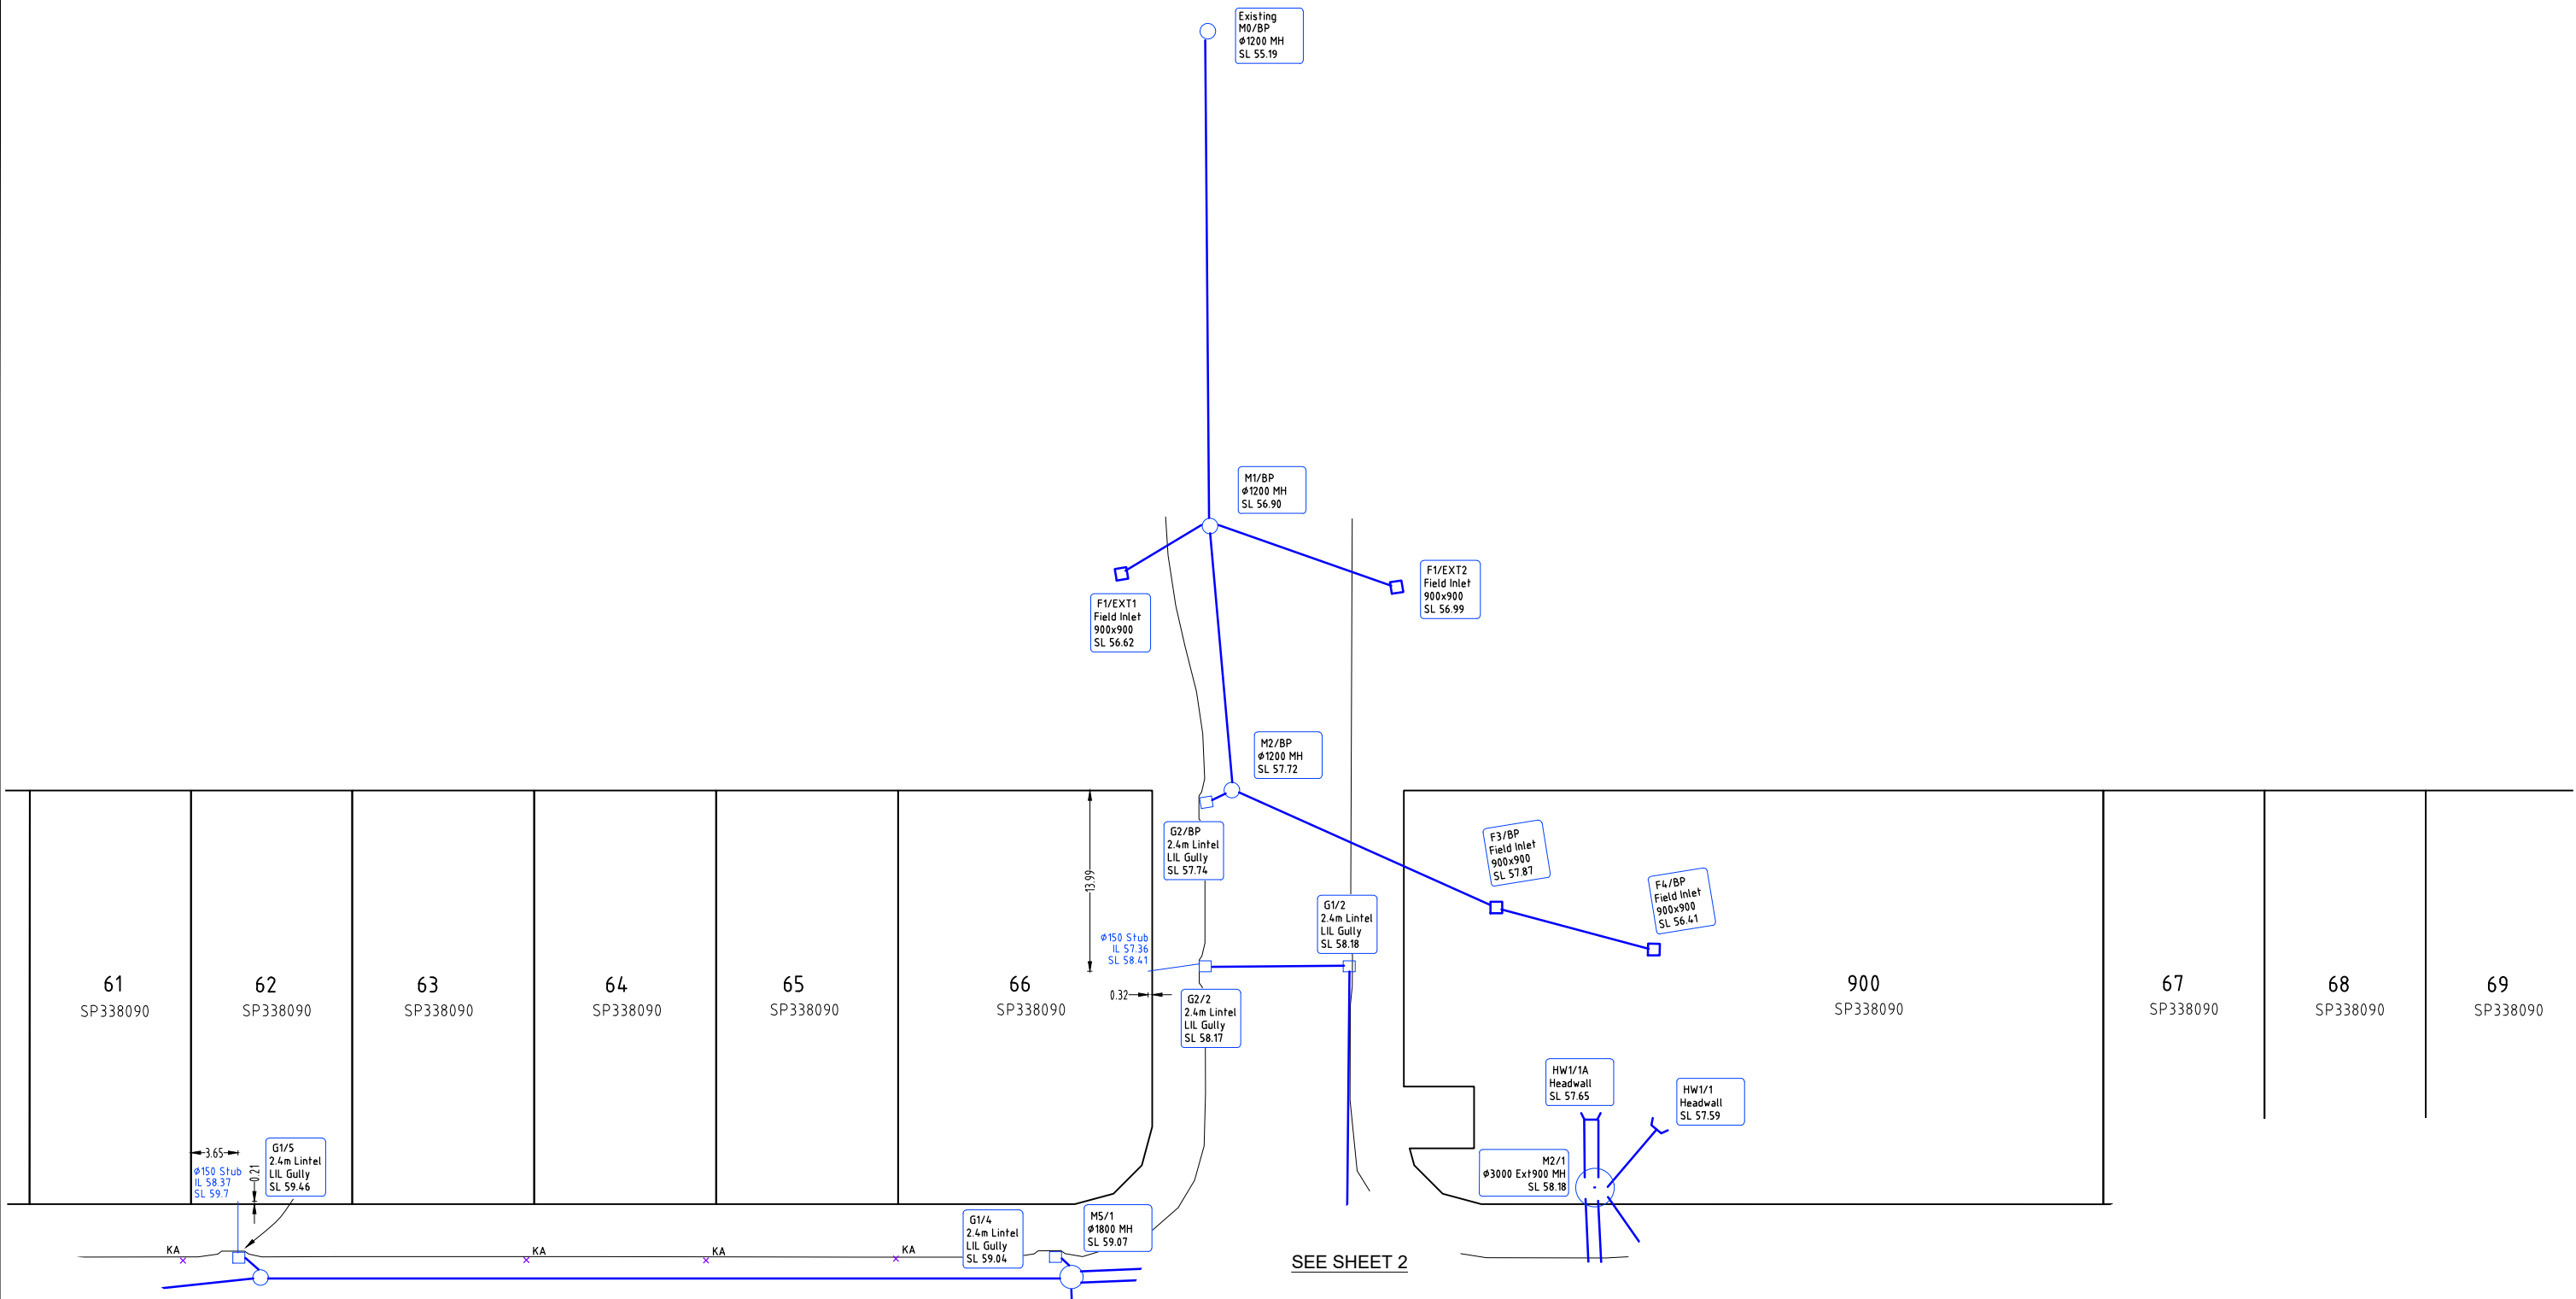


AS CONSTRUCTED

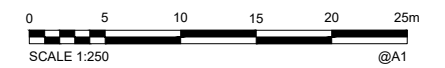

A1	INDEX	DATE	REVISIONS	DRAWN	CHECKED	PASSED
	A	18/10/2023	Builder's Issue			

DRAWN	CH	10/10/2023
CHECKED	JL	12/10/2023
PASSED		
INITIALS	DATE	

SH saunders havill group
 Brisbane Springfield
 head office 9 Thompson St Bowen Hills Q 4006
 phone 1300 423 SHG web www.saundershavill.com
 Drawing No: 11200 S 05 AC A

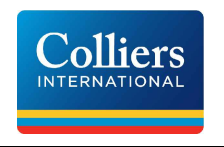


BRISBANE CITY COUNCIL
 AS CONSTRUCTED - DRAINAGE
 ADORA ESTATE
 2875 BEAUDESERT ROAD, PARKINSON

SCALE	1:250
SHEET	3 OF 5 SHEETS
DRAWING NO.	




SEE SHEET 5

SEE SHEET 2

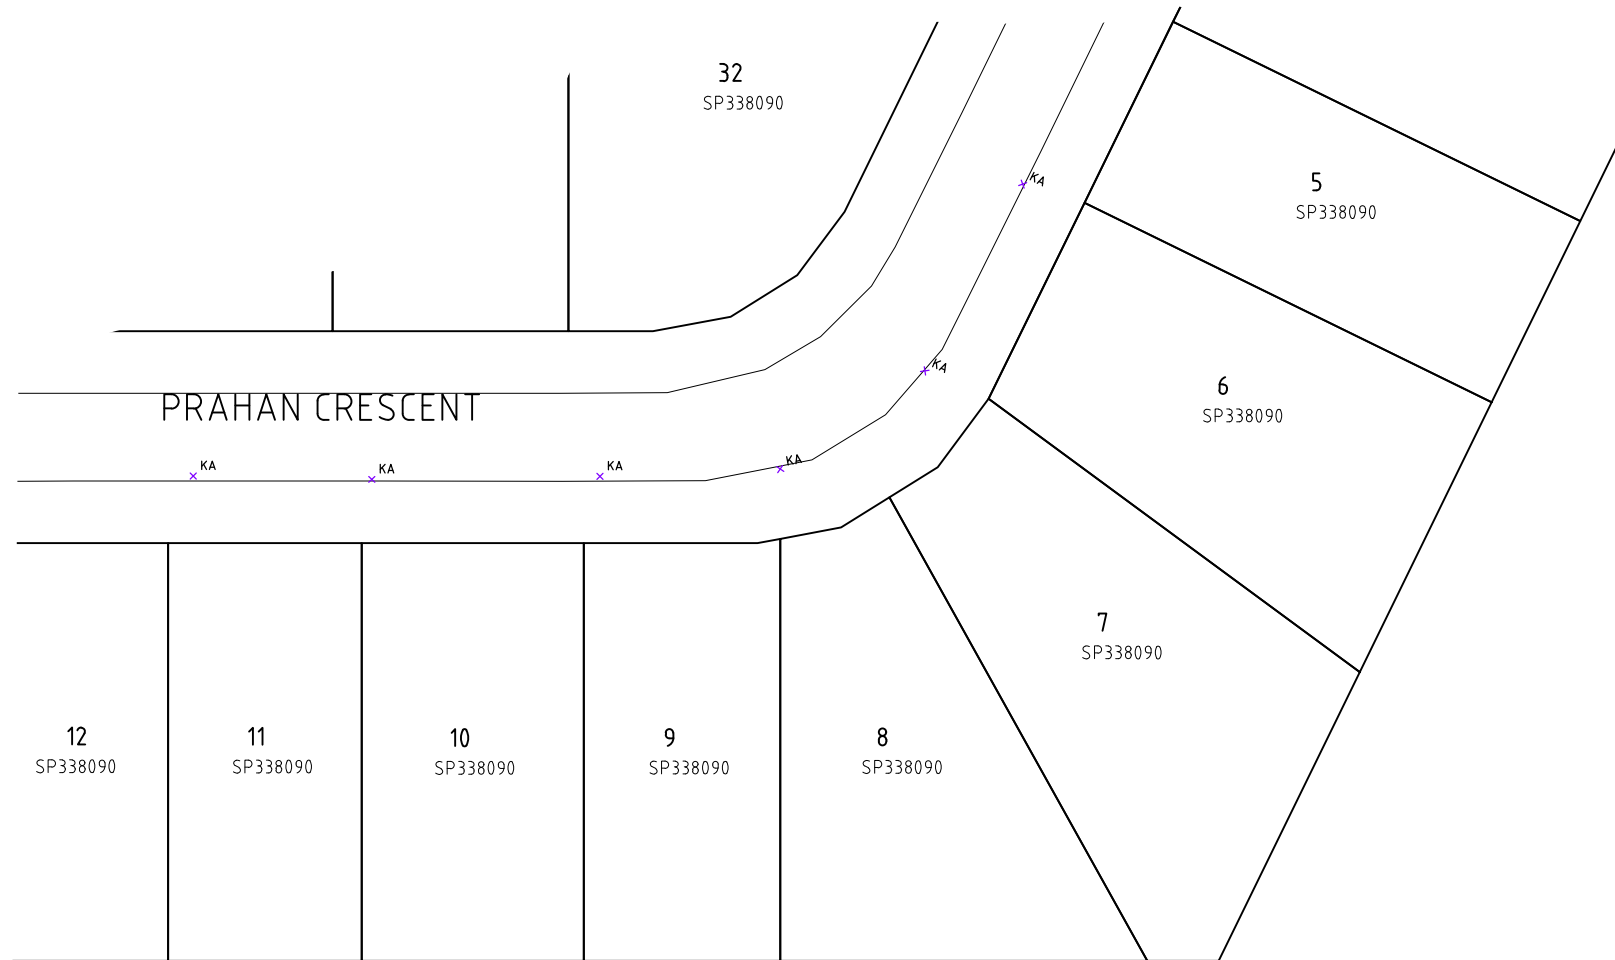

AS CONSTRUCTED

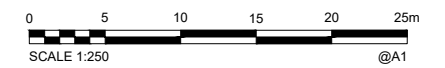


A1

INDEX	DATE	REVISIONS	DRAWN	CHECKED	PASSED
A	18/10/2023	Builder's Issue			


DRAWN	CM	10/10/2023
CHECKED	JL	12/10/2023
PASSED		
INITIALS	DATE	

SH saunders havill group
 Brisbane Springfield
 head office 9 Thompson St Bowen Hills Q 4006
 phone 1300 423 SHG web www.saundershavill.com
 Drawing No: 11200 S 05 AC A

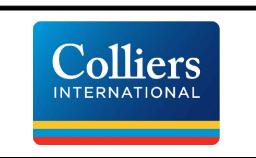


BRISBANE CITY COUNCIL
 AS CONSTRUCTED - DRAINAGE
 ADORA ESTATE
 2875 BEAUDESERT ROAD, PARKINSON

SCALE	1:250
SHEET	4 OF 5 SHEETS
DRAWING NO.	

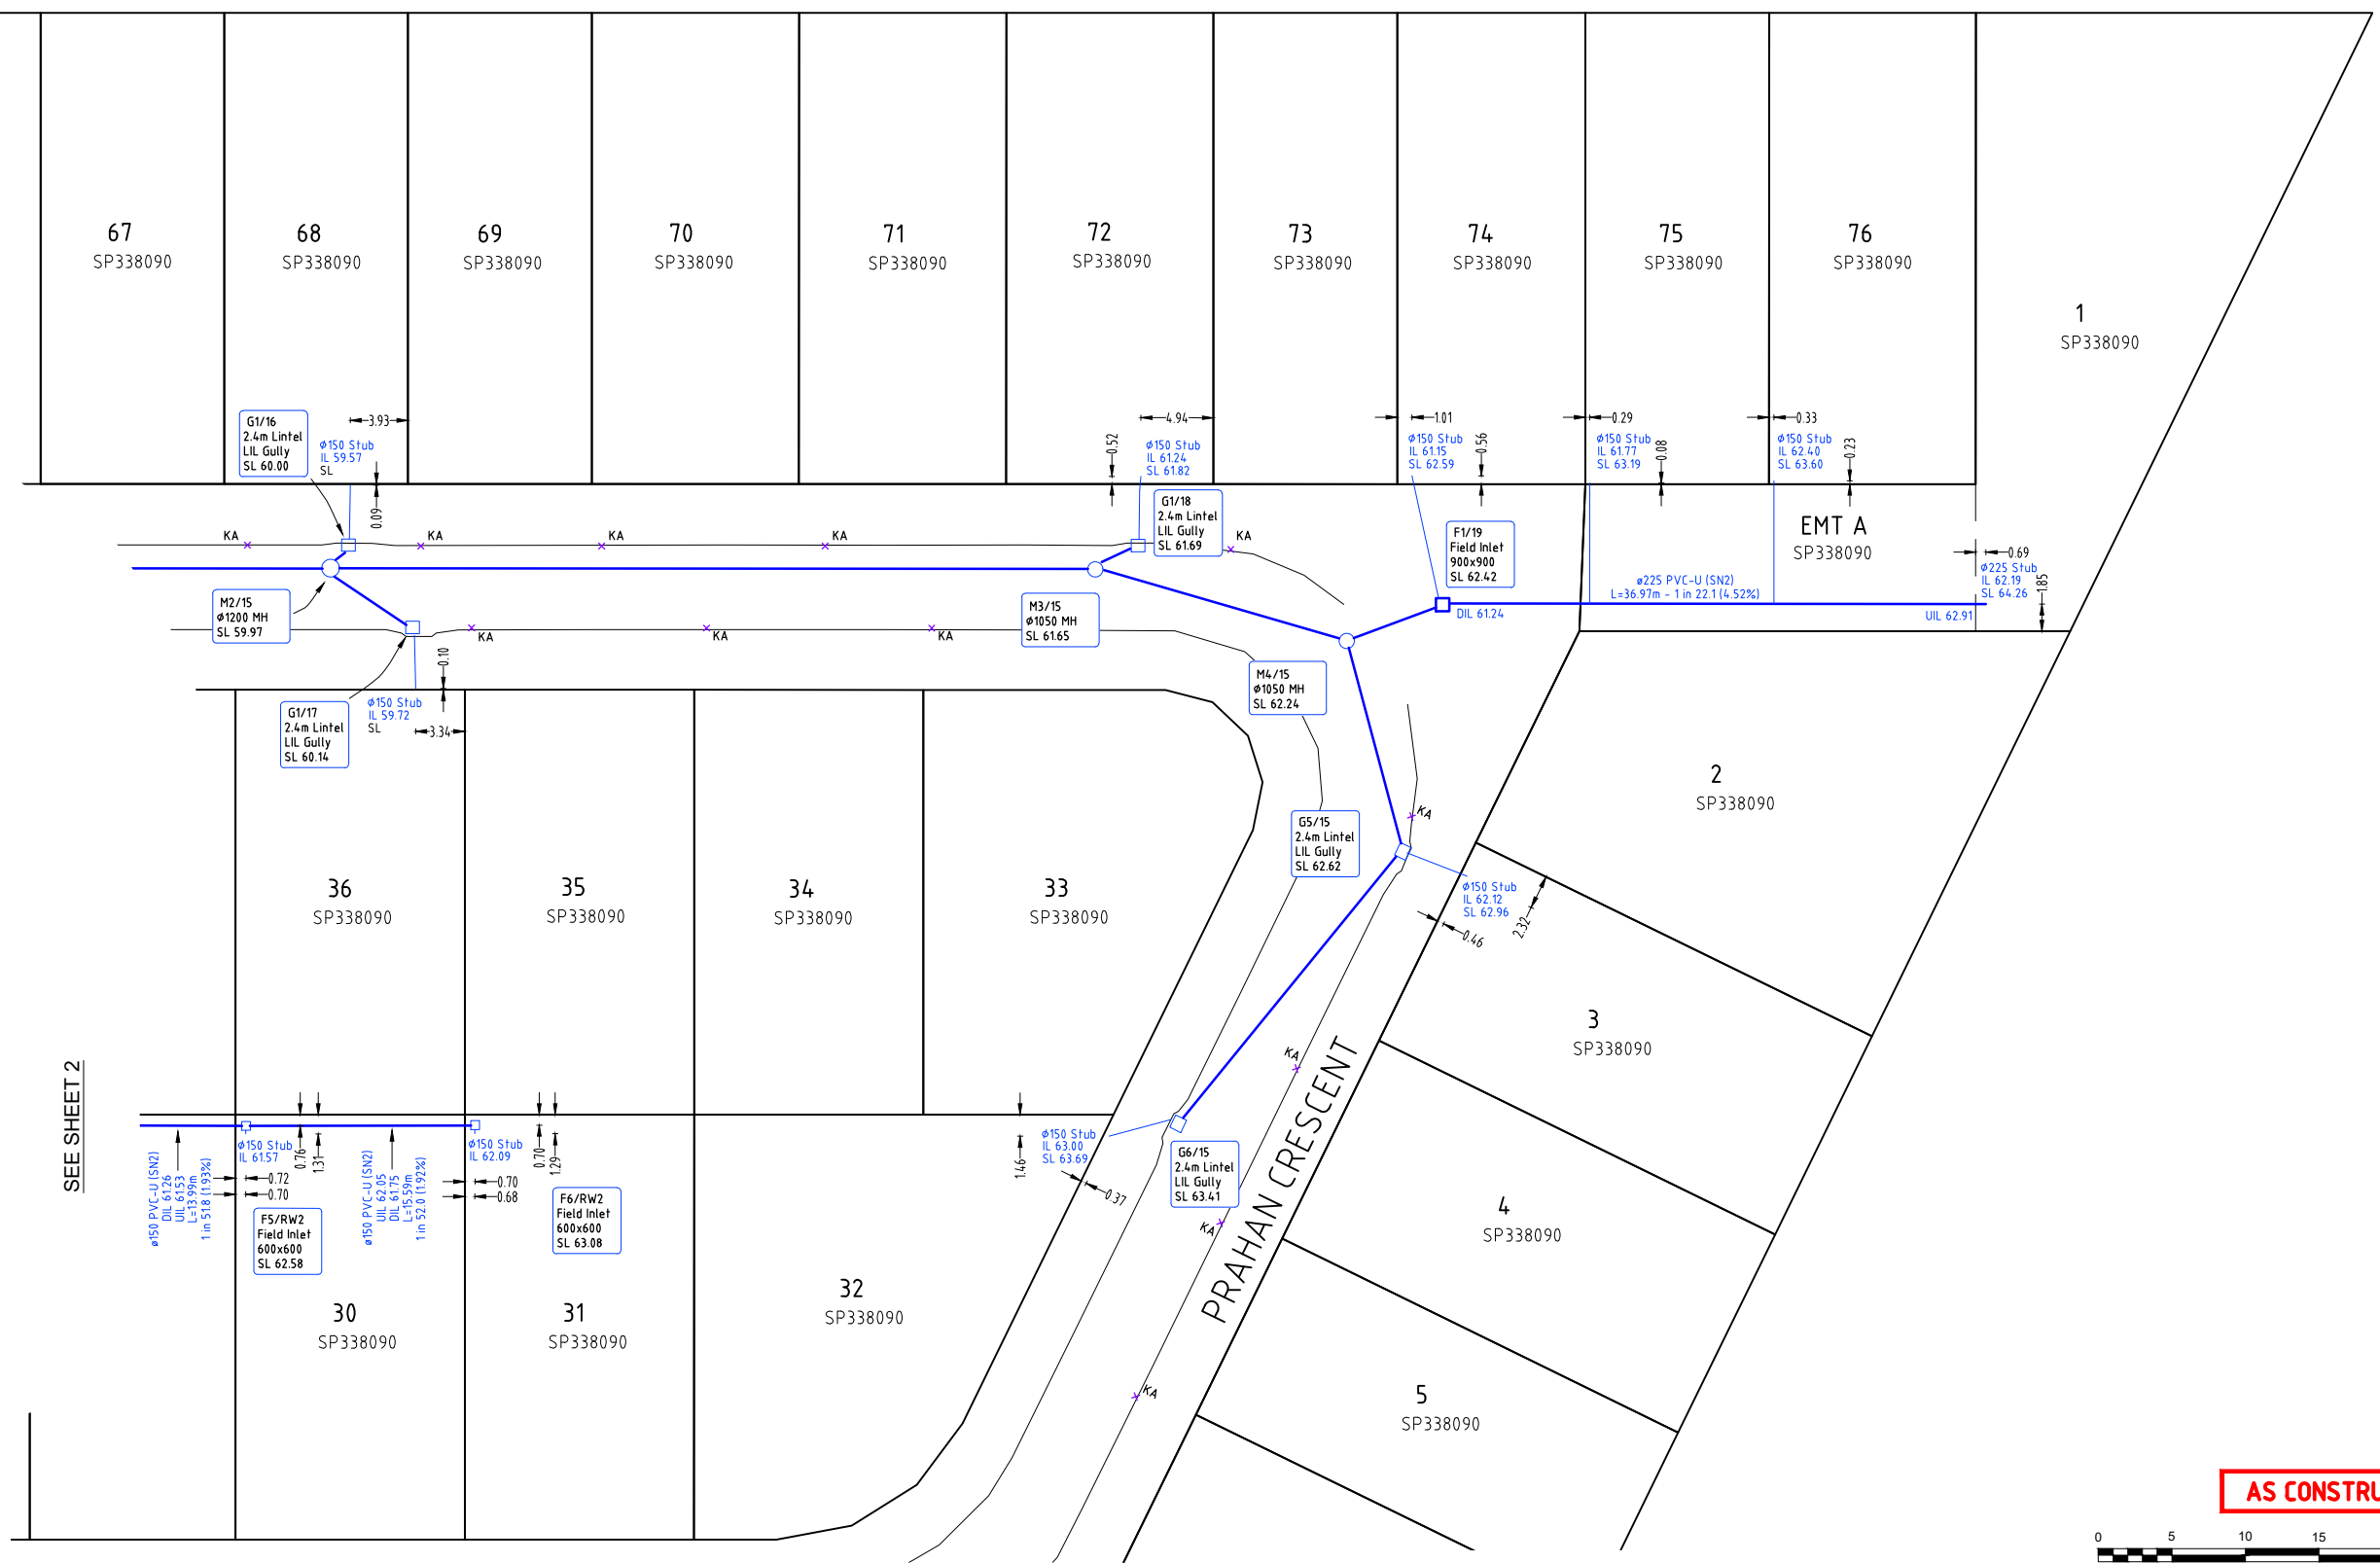

SEE SHEET 2

AS CONSTRUCTED

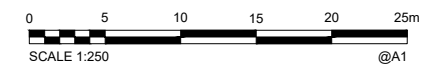

A1	INDEX	DATE	REVISIONS	DRAWN	CHECKED	PASSED
	A	18/10/2023	Builder's Issue			

DRAWN	CH	10/10/2023
CHECKED	JL	12/10/2023
PASSED		
INITIALS	DATE	

SH saunders havill group
 Brisbane Springfield
 head office 9 Thompson St Bowen Hills Q 4006
 phone 1300 423 SHG web www.saundershavill.com
 Drawing No: 11200 S 05 AC A

Colliers INTERNATIONAL

BRISBANE CITY COUNCIL
 Dedicated to a better Brisbane

BRISBANE CITY COUNCIL
 AS CONSTRUCTED - DRAINAGE
 ADORA ESTATE
 2875 BEAUDESERT ROAD, PARKINSON

SCALE	1:250
SHEET	5 OF 5 SHEETS
DRAWING NO.	